


CERTIFIED RECORD OF LAND CORNER MONUMENTATION

History of original corner establishment:

40.00 Set a basalt stone 16 x 6 x 6 in. 11 in. in ground
for $\frac{1}{4}$ cor. marked $\frac{1}{4}$ on W. face from which
A pine 24 in. in diam. bears S. 65° E. 76 lks. dist.
marked $\frac{1}{4}$ S. B.T.
A pine 16 in. in diam. bears N. 65° W. 64 lks. dist.
marked $\frac{1}{4}$ S. B.T.

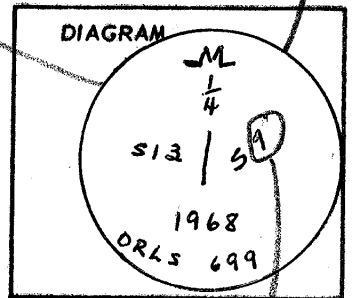

Description of corner evidence found:

B.T.: a P. pine 26 in. in diam. bears N. 65° W. 42.2 ft.


Description of monument and accessories I established to perpetuate the original location of this corner

Set iron pipe 1 x 30 in. with brass cap, jutting from ground 8 in.

Open pine slope near top of ridge and intersection of hog back. Scattered pine and fir reproduction.



Leland Lee Myers

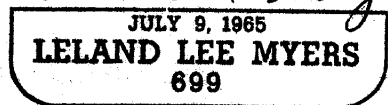

Office of County of
State of , I hereby certify that the within instrument was filed in this office
for record on the day of; 19....., at..... o'clockm., (signed)
..... by
(COUNTY OFFICIAL) (DEPUTY)

FILED Jan 7, 1981
BAKER COUNTY SURVEYOR
SURVEY NO. 10-35-71