


CERTIFIED RECORD OF LAND CORNER MONUMENTATION

History of original corner establishment:

80.00 Set a basalt stone 14 x 10 x 6 in. 9 in. in ground for cor. to Secs. 13, 14, 23, and 24 marked with 3 notches on S. and 1 notch on E. edges from which
A black pine 12 in. in diam. bears N. 45° E. 235 lks. dist. marked T. 10 S., R. 35 E., S. 13 B.T.
A black pine 10 in. in diam. bears S. 53° E. 234 lks. dist. marked T. 10 S., R. 35 E., S. 24 B.T.
A black pine 12 in. in diam. bears S. 44° W. 254 lks. dist. marked T. 10 S., R. 35 E., S. 23 B.T.
A black pine 12 in. in diam. bears N. 40° W. 163 lks. dist. marked T. 10 S., R. 35 E., S. 14 B.T.

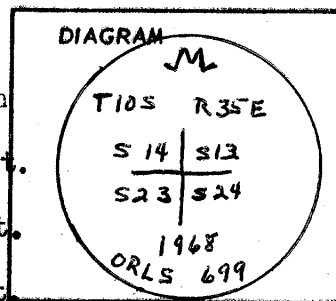

Description of corner evidence found:


Found a down Lodgepole pine with a blaze but no legible scribing. Found rotted off stumps in proper location for other B.T.s. Did not find marked rock. Established brass cap from the meager evidence found.

Description of monument and accessories | established to perpetuate the original location of this corner

Set iron pipe 1 x 30 in. with brass cap, jutting from ground 12 in.

Ref. Tree: a LP pine 16 in. in diam. bears N 52° W. 94.8 ft.
a pine 24 in. in diam. bears S. 26° E. 133 ft.

Corner is in middle of large meadow-like opening.

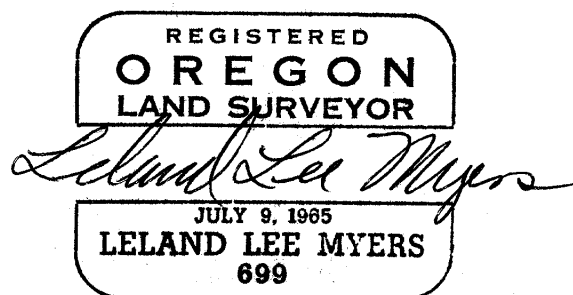

Office of County of
State of , I hereby certify that the within instrument was filed in this office
for record on the day of , 19..... , at o'clock m., (signed)
..... by
(COUNTY OFFICIAL) (DEPUTY)

FILED Jan 7, 1981
BAKER COUNTY SURVEYOR
SURVEY NO. 10-35-72