


CERTIFIED RECORD OF LAND CORNER MONUMENTATION

History of original corner establishment:

- 40.26 Set a post $3\frac{1}{2}$ ft. long, 3 in. square, 24 in. in ground for $\frac{1}{4}$ cor. marked $\frac{1}{4}$ S. on N. face from which
A tamarac 20 in. in diam. bears N. 15° E. 38 lks. dist. marked $\frac{1}{4}$ S. B.T.
A pine 28 in. in diam. bears S. 5° W. 57 lks. dist. marked $\frac{1}{4}$ S. B.T.

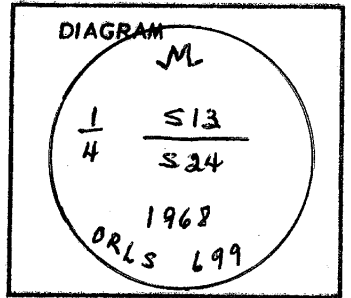

T10S, R135E.


Description of corner evidence found:

Found both B.T.s in good condition, but no post. Established brass cap corner by measurement from B.T.s:
A larch 24 in. in diam. bears N. 5° E. 25.3 ft.
A pine 26 in. in diam. bears S. 11° W. 37.3 ft.

Description of monument and accessories | established to perpetuate the original location of this corner

Set iron pipe 1 x 30 in. with brass cap, jutting from ground 8 in.

Corner is in small saddle of ridge running South. Timber is dense mixed species to West of corner and open scattered pine otherwise.

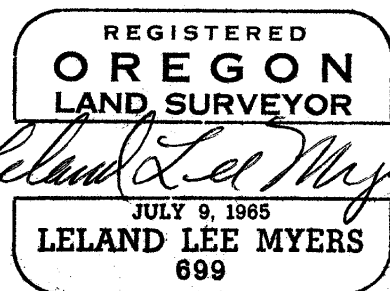

Office of..... County of.....
State of....., I hereby certify that the within instrument was filed in this office
for record on the day of; 19....., at..... o'clockm., (signed)
..... by
(COUNTY OFFICIAL) (DEPUTY)

FILED Jan 7, 1981

BAKER COUNTY SURVEYOR
SURVEY NO. 10-35-73