


CERTIFIED RECORD OF LAND CORNER MONUMENTATION

History of original corner establishment:

None

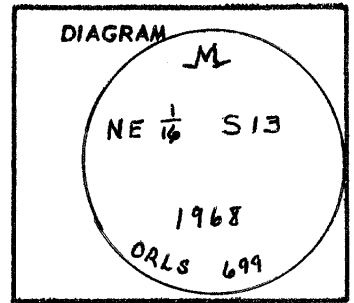

T. 10S. R. 35E.

Description of corner evidence found:

None

Description of monument and accessories established to perpetuate the original location of this corner

Set iron pipe 1 x 30 in. with brass cap, jutting from ground 14 in. and surrounded by rocks. Scattered pine slope with good second growth near bottom of dry draw. Small spring just to N.

Ref. Tree: a P. pine 12 in. in diam. bears S. 13° E. 31.5 ft.



Office of..... County of.....
State of....., I hereby certify that the within instrument was filed in this office
for record on the day of; 19....., at..... o'clockm., (signed)
..... by
(COUNTY OFFICIAL) (DEPUTY)

FILED Jan 7 1981

BAKER COUNTY SURVEYOR
SURVEY NO. 10-35-76