


CERTIFIED RECORD OF LAND CORNER MONUMENTATION

History of original corner establishment:

None

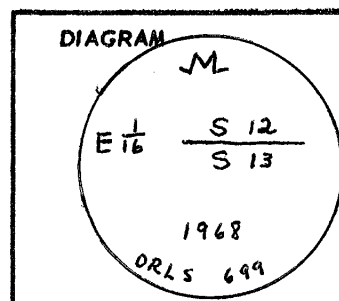

T. 10S. R. 35E.


Description of corner evidence found:

None

Description of monument and accessories | established to perpetuate the original location of this corner

Set iron pipe 1 x 30 in. with brass cap, jutting from ground 8 in.
Monument located about 300 ft. W. from top of ridge, 200 ft. W. of old road.
Timber mostly LP. pine with scattered fir. Ground gently sloping.

Ref. Tree: a D. fir 20 in. in diam. bears S. 45° E. 19.6 ft.

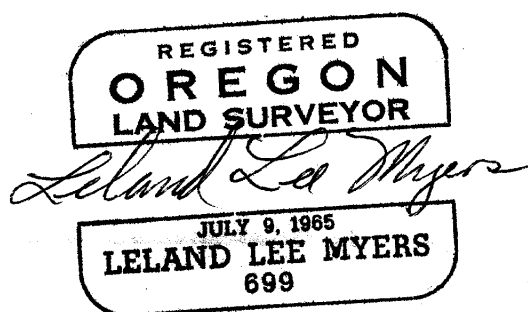

Office of County of
State of , I hereby certify that the within instrument was filed in this office
for record on the day of , 19..... , at o'clockm., (signed)
..... by
(COUNTY OFFICIAL) (DEPUTY)

FILED Jan 7, 1981


FILE NO. 10-35-77