

CERTIFIED RECORD OF LAND CORNER MONUMENTATION

Index File No. J-9

History of original corner establishment:

Corner was originally established by Herman D. Gradon under GLO contract No. 416, during October, 1881.

The corner was remonumented by L. Myers in 1972.

In September, 1980, under U. S. F. S. contract I was engaged to bring the corner up to U. S. F. S. standards.

DIAGRAM

T10S R35E
S8 + S9
S17 | S16

Description of corner evidence found:

Found Aluminum Cap on 1 1/4" galvanized pipe projecting 12" above the ground and stamped:
Built mound of stone around to cap.
By magnetic declination of N20°E:
48" Fir, bears N15°E, 60.8 ft. scribing not visible.
44" dead fir with scribing bears S39°W, 29.0 ft,

ORLS 699
T10S R35E
S8 + S9
S17 | S16
M
1972


Description of monument and accessories I established to perpetuate the original location of this corner:

I perpetuate the corner by adding:
16" Fir, bears S04°E, 107.1 ft. scribed T10S R35E S16 BT,
10" white fir, bears S72°W, 50.5 ft. scribed T10S R35E S17 BT,
30" tamarac, bears N73°W, 121.8 ft. scribed T10S R35E S8 BT.
Painted blazes red and 6" red band around. Placed 54-3s, 54-4s, and brass washers stamped PLS 1051 on the BTs. Placed 54-4 on a steel fence post 5' east of the corner.

I hereby certify that the above work was done to perpetuate the described found corner monument.

Witnesses: Daniel Rowland
Larry Shirley

September 12, 1980

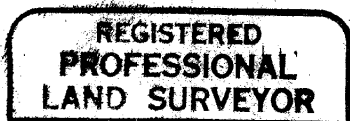

Barry B. Barbour
OREGON
OCT. 17, 1975
BARRY B. BARBOUR
1051

Office of.....County Surveyor.....County of.....Baker
State of.....Oregon....., I hereby certify that the within instrument was filed in this office
for record on the...20th day of...January....., 1981.
.....by.....
(COUNTY OFFICIAL) (DEPUTY)