

CERTIFIED RECORD OF LAND CORNER MONUMENTATION

Index File No. J-11

History of original corner establishment:

Corner was originally established by Herman D. Gradon under GLO contract No. 416, during October, 1881.

The corner was remonumented by L. Myers in 1972.

In September, 1980, under U. S. F. S. contract I was engaged to bring the corner up to U. S. F. S. standards.

DIAGRAM

T10S R35E
S9

1/4 ————

S16

Description of corner evidence found:

Found Aluminum Cap on 1 1/4" galvanized pipe projecting 14" above the ground and stamped:

The 1/4 on the cap points S50°E. Rebuilt mound of stone around to cap.

ORLS 699

S9

1/4 ————

S16

M

1972

Description of monument and accessories I established to perpetuate the original location of this corner:

From which by magnetic declination of N20°E, I perpetuate the corner by adding:

12" lodgepole pine bears N08°E, 102.3 ft. scribed 1/4 S9 BT.


18" lodgepole pine bears S23°E, 68.2 ft. scribed 1/4 S16 BT.

Painted blazes red and 6" red band around. Placed 54-3s, 54-4s, and brass washers stamped PLS 1051. Placed 54-4 on a steel fence post 5' west of the corner.

I hereby certify that the above work was done to perpetuate the described found corner monument.

Witnesses: Daniel Rowland
Larry Shirley

September 10, 1980

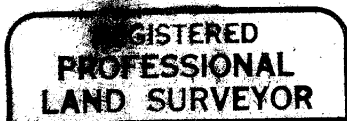

Barry B. Barbours
OREGON
OCT. 17, 1975
BARRY B. BARBOURS
1051

Office of..... County Surveyor..... County of..... Baker
State of..... Oregon....., I hereby certify that the within instrument was filed in this office
for record on the 20th day of January....., 1981
..... by
(COUNTY OFFICIAL) (DEPUTY)

Form R6-7100-57 (9/71)

FILED Jan 20 1981 ☆ GPO—798-276
BAKER COUNTY SURVEYOR
SURVEY NO. 10-35-81