

CERTIFIED RECORD OF LAND CORNER MONUMENTATION

Index File No, N-13

History of original corner establishment:

Corner was originally established by Herman D. Gradon under G.L.O. contract No 416 during October, 1881, Surveyor General's notes state: "Set a basalt stone 20x12x5 ins. 15 ins. in the ground for cor. to secs. 15, 16, 21, and 22, marked with 3 notches on S and E edges: From which, A pine 12 ins. diam. bears N20°E 55 lks. dist. marked T10SR35ES15 BT. A pine 30 ins. diam. bears S30°E, 34 lks. dist. marked T10SR35ES22 BT. A pine 24 ins. diam. bears S45°W, 26 lks. dist. marked T10SR35ES21 BT. A pine 36 ins. diam. bears N17°W, 45 lks. dist. marked T10SR35ES16 BT."

DIAGRAM

T10S	R35E
S16	S15
S21	S22

Description of corner evidence found:

Found 20x16x4 inch stone in small mound of stone, firmly set and marked with 3 notches on S and E sides, from which a 34" pine bears S28°E, 24.7 ft. with partially grown over blaze and visible scribing. Other BTs down and rotten.

Description of monument and accessories | established to perpetuate the original location of this corner:

T10S	R35E
S16	S15
S21	S22


OR PLS 1051
1980

At the center of the above stone, set 2 1/2" X 30" galvanized pipe and brass cap marked: Set pipe 20" in the ground and mound of stone around to cap. From which by magnetic declination of N20°E: A 32" pine bears N39°E, 111.7 ft. scribed T10S R35ES15 BT. A 22" pine bears S23°W, 50.1 ft. scribed T10SR35ES21 BT. A 14" Fir bears N79°W, 89.8 ft. scribed T10SR35ES16 BT. Painted blazes red and 6" red band around. Placed 54-3s, 54-4s and brass washers stamped PLS 1051 on BTs. Placed 54-4 on steel fence post 5' West of the corner.

I hereby certify that the above corner monument was reestablished as herein described.

Witnesses: Robert Boling
Larry Shirley

July 24, 1980

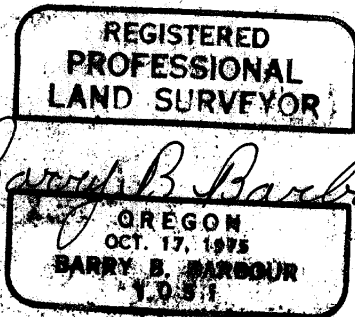

Office of.....County Surveyor..... County of...Baker.....
State of...Oregon....., I hereby certify that the within instrument was filed in this office
for record on the...20th day of...January....., 1981.

..... by
(COUNTY OFFICIAL) (DEPUTY)

FILED Jan 20 1981
BAKER COUNTY SURVEYOR
SURVEY NO. 10-35-88