


CERTIFIED RECORD OF LAND CORNER MONUMENTATION

Index File No. 0-P-13

History of original corner establishment:

None.

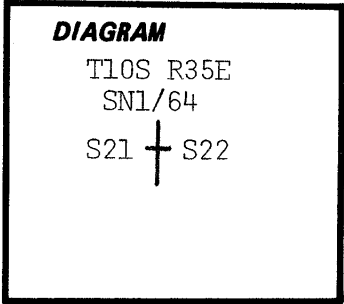

Description of corner evidence found:

None.

Description of monument and accessories I established to perpetuate the original location of this corner:

At surveyed point set 2 1/2" X 30" galvanized pipe and brass cap marked: Set pipe 20" in the ground and mound of stone around to cap.

T10S R35E
SN1/64
S21 + S22
OR PLS 1051
1980

From which by magnetic declination of N20°E;
An 18" pine bears N57°E, 89.2 ft. scribed SN 1/64 S22 BT.
A 9" fir bears S75°W, 54.2 ft. scribed SN 1/64 S21 BT, Painted blazes red and 6" red band around. Placed 54-3s, 54-9s, and brass washer stamped PLS 1051 on the BTs. Placed 54-2 and 54-9 on a steel fence post 5' south and 54-2 on a steel fence post 5' west of the corner.

I hereby certify that the above corner monument was reestablished as herein described.

Witnesses: Daniel Rowland
Larry Shirley

August 27, 1980



Office of..... County Surveyor..... County of..... Baker.....
State of..... Oregon....., I hereby certify that the within instrument was filed in this office
for record on the 20th day of..... January....., 1981.
..... by
(COUNTY OFFICIAL) (DEPUTY)

FILED Jan 20, 1981
BAKER COUNTY SURVEYOR
SURVEY NO. 10-35-96