


CERTIFIED RECORD OF LAND CORNER MONUMENTATION

Index File No. P-12

History of original corner establishment:
None.

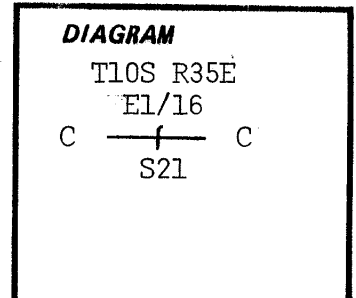

Description of corner evidence found:

None.

Corner fell 0.3 ft. east of 8" white fir. Cut tree down and plsced pipe
alongside of stump.

Description of monument and accessories | established to perpetuate the
original location of this corner:

T10S R35E
E1/16
C ——— C
S21
OR PLS 1051
1980

At surveyed point set 2 1/2" X 30" galvanized pipe
and brass cap marked: Set pipe 25" in the ground
and mound of stone around to stump.

From which by magnetic declination of N20°E:

A 9" fir bears N48°E, 18.8 ft. scribed CE1/16

S21 BT. A 16" pine bears S39°E, 36.4 ft. scribed CE1/16S21 BT. Painted
blazes red and 6" red band around. Placed 54-3s, 54-9s and brass washers
stamped PLS 1051 on BTs. Placed 54-2 and 54-9 on steel fence post 5' north
and 54-2 on steel fence post 5' west of the corner.

I hereby certify that the above
corner monument was reestablished
as herein described.

Witnesses: Daniel Rowland
Larry Shirley

August 27, 1980

REGISTERED
PROFESSIONAL
LAND SURVEYOR

Barry B. Barbour

OREGON
OCT. 17, 1975
BARRY B. BARBOUR
1051

Office of.....County Surveyor.....County of.....Baker.....
State of.....Oregon.....I hereby certify that the within instrument was filed in this office
for record on the 20th day of.....January....., 1981
.....by.....
(COUNTY OFFICIAL) (DEPUTY)

Form R6-7100-57 (9/71)

☆ GPO 799-509

FILED Jan 20, 1981
BAKER COUNTY SURVEYOR
SURVEY NO. 10-35-99