


CERTIFIED RECORD OF LAND CORNER MONUMENTATION

Index File No. P-17

History of original corner establishment:

Corner was originally established by Herman D. Gradon under G.L.O. contract No 416 during October, 1881. Surveyor General's notes state: "Set a basalt stone 16x8x5 ins., 11 ins. in the ground for 1/4 sec. cor. marked 1/4 on W. face: from which, A pine 36 ins. diam. bears S53°E, 44 lks. dist. marked 1/4S BT. A pine 6 ins. diam. bears S80°W, 15 lks. dist. marked 1/4S BT."

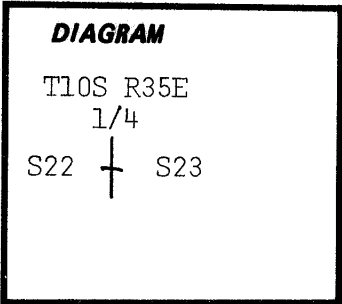

Description of corner evidence found:

Found no trace of corner stone. Measured N80°E, 9.9 ft. from grown over 20" pine. From which a 40" pine stump bears S52°E, 29.9 ft. scribed 1/4S BT.

Corner is 50 ft. east of the road.

Description of monument and accessories | established to perpetuate the original location of this corner:

At the center of the above point, set 2 1/2" X 30" galvanized pipe and brass cap marked: Set pipe 24" in the ground and mound of stone around to cap.

From which by magnetic declination of N20°E:

A 24" pine bears S84°E, 39.9 ft. scribed 1/4S23 BT. Painted blazes red and 6" red band around. Placed 54-3, 54-4 and brass washers stamped PLS 1051 on BTs. Old BTs are signed. Placed 54-4 on steel fence post 5' South of the corner.

T10S R35E
1/4
S22 + S23
OR PLS 1051
1980

I hereby certify that the above corner monument was reestablished as herein described.

Witnesses: Robert Boling
Larry Shirley

July 22, 1980



Barry D. Barbour
OREGON
OCT. 17, 1978
BARRY D. BARBOUR
P.L.S.

Office of.....County Surveyor..... County of.....Baker.....
State of.....Oregon....., I hereby certify that the within instrument was filed in this office
for record on the..20th day of...January....., 19..81

..... by
(COUNTY OFFICIAL) (DEPUTY)

FILED Jan 20 1981
BAKER COUNTY SURVEYOR
SURVEY NO. 10-35-103