


CERTIFIED RECORD OF LAND CORNER MONUMENTATION

Index File No. P-21

History of original corner establishment:

Corner was originally established by Herman D. Gradon under GLO contract No. 416 in October, 1881. Surveyers Generals notes state: "Set a basalt stone 16x6x6 ins., 11 ins. in the ground, for 1/4 sec. cor.-marked 1/4 on W face: from which A pine 10 ins. diam. bears S55°E, 54 lks. dist. marked 1/4S BT. A pine 24 ins. diam. bears S15°W, 50 lks. dist. marked 1/4S BT."

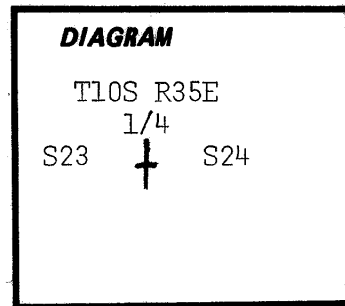

Description of corner evidence found:

Found clearly marked 14x8x8 inch stone firmly set and clearly marked 1/4 on west side from which: A down and rotten 10" lodgepole pine bears S48°E, 37.0 ft. with 1/4 S BT visible. A 38" pine with grown over blaze bears S15°W, 33.0 ft.

Description of monument and accessories I established to perpetuate the original location of this corner:

At the center of the above rock set 2 1/2" X 30" galvanized pipe and brass cap marked: Set pipe 26" in the ground and mound of stone around to cap. Placed marked stone at base of pipe.


From which by magnetic declination of N20°E: A 9" lodgepole pine bears N52°E, 21.5 ft. scribed 1/4S24 BT. Painted blazes red and 6" red band around. Placed 54-3, 54-4 and brass washres stamped PLS 1051 on BTs. Old BTs are signed. Placed 54-4 on steel fence post 5" south of the corner.

T10S R35E
1/4
S23 + S24
OR PLS 1051
1980


I hereby certify that the above corner monument was reestablished as herein described.

Witnesses: Daniel Rowland
Doug Moser

October 22, 1980

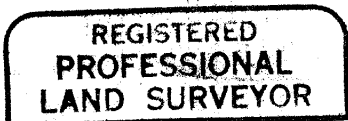

Barry B. Barbour

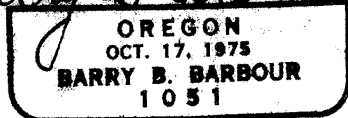

Office of... Baker County Surveyor... County of... Baker...
State of... Oregon... I hereby certify that the within instrument was filed in this office
for record on the... 20th day of... January... , 19... 81...
..... by
(COUNTY OFFICIAL) (DEPUTY)

FILED Jan 20 1981
BAKER COUNTY SURVEYOR
SURVEY NO. 10-35-104