


CERTIFIED RECORD OF LAND CORNER MONUMENTATION

Index File No. P-Q-13

History of original corner establishment:

None.

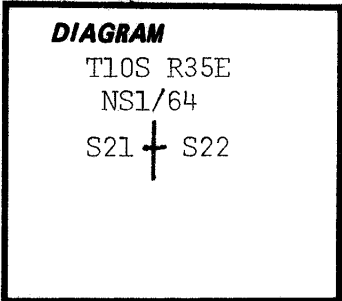

Description of corner evidence found:

None.

Corner fell 1 ft. north of tree marked for corner and at the south edge of small mound of stone. Corner is 15' east of the road,

Description of monument and accessories | established to perpetuate the original location of this corner:

At surveyed point set 2 1/2" X 30" galvanized pipe and brass cap marked: Set pipe 25" in the ground and mound of stone around to cap.

T10S R35E
NS1/64
S21 + S22
OR PLS 1051
1980

From which by magnetic declination of N20°E;
A 12" pine bears S36°E, 36.3 ft., scribed NS 1/64 S22 BT,
A 12" pine bears N32°W, 28.0 ft, scribed S 1/64 S21 BT. Painted blazes red and 6" red band around. Placed 54-3s, 54-9s, and brass washers stamped PLS 1051 on the BTs. Placed 54-2 and 54-9 on a steel fence post 5' east and 54-2 on a steel fence post 5' south of the corner,

I hereby certify that the above corner monument was reestablished as herein described.

Witnesses: Daniel Rowland
Larry Shirley

August 7, 1980



Office of.....County...Surveyor..... County of.....Baker.....
State of.....Oregon....., I hereby certify that the within instrument was filed in this office
for record on the 20th day of.....January....., 1981.
..... by
(COUNTY OFFICIAL) (DEPUTY)

FILED Jan 20 1981
BAKER COUNTY SURVEYOR
SURVEY NO. 10-35-105