


CERTIFIED RECORD OF LAND CORNER MONUMENTATION

Index File No. P-0-15

History of original corner establishment:

None.

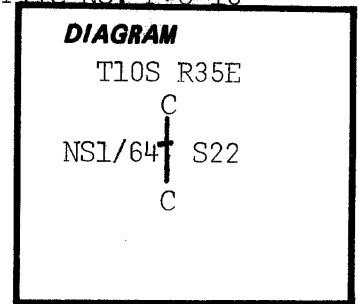

Description of corner evidence found:

Not Set.

Corner falls in small draw about 400' north of road.

Description of monument and accessories | established to perpetuate the original location of this corner:

At surveyed point set 2 1/2" X 30" galvanized pipe and brass cap marked: Set pipe 24" in the ground and mound of stone around to cap.

From which by magnetic declination of N20°E: A 12" pine bears S40°E, 66.1 ft. scribed CNS 1/64 S22 BT, A 12" pine bears N71°W, 37.9 ft. scribed CNS 1/64 S22 BT, Painted blazes red and 6" red band around. Placed 54-3s, 54-4s, and brass washers stamped PLS 1051 on the BTs. Placed 54-2 and 54-9 on a steel fence post 5' east of the corner.

T10S R35E
C
NS1/64 S22
C
OR PLS 1051
1980

I hereby certify that the above corner monument was reestablished as herein described.

Witnesses: Daniel Rowland
Larry Shirley

August 6, 1980

**REGISTERED
PROFESSIONAL
LAND SURVEYOR**

Barry B. Barbour

**OREGON
OCT. 17, 1975
BARRY B. BARBOUR
1051**

Office of.....County Surveyor..... County of.....Baker.....
State of.....Oregon....., I hereby certify that the within instrument was filed in this office
for record on the 20th day of January....., 1981
..... by
(COUNTY OFFICIAL) (DEPUTY)

Form R6-7100-57 (9/71)

☆ GPO—798-276

FILED Jan 20 1981
BAKER COUNTY SURVEYOR
SURVEY NO. 10-35-108