


CERTIFIED RECORD OF LAND CORNER MONUMENTATION

Index File No. Q-14-15

History of original corner establishment:

None.

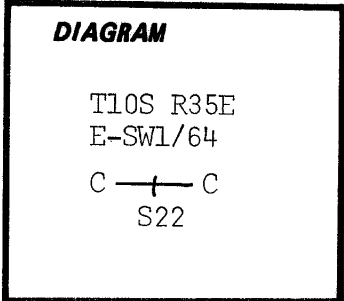


Description of corner evidence found:

None.

Description of monument and accessories | established to perpetuate the original location of this corner:

At surveyed point set 2 1/2" X 6" galvanized pipe and brass cap marked: Set pipe on bedrock with cement. Built mound of stone west of corner. From which by amgnetic declination of N20°E: A 16" tamarac bears N55°E, 78.6 ft. scribed CESW1/64S22 BT. A 25" pine bears N77°W, 111.0 ft. scribed CESW1/64S22 BT. Painted blazes red and 6" red band around. Placed 54-3s, 54-9s and brass washers stamped PLS 1051 on BTs. Placed 54-2 and 54-9 on steel fence post 5' north and 54-2 on steel fence post 5' east of the corner.

T10S R35E
E-SW1/64
C —+— C
S22
OR PLS 1051
1980

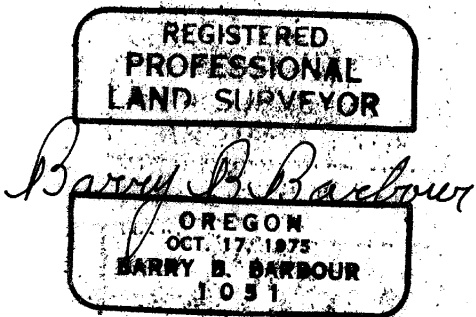

I hereby certify that the above corner monument was reestablished as herein described.

Witnesses: Daniel Rowland
Larry Shirley

August 21, 1980

Office of...County Surveyor...County of...Baker
State of...Oregon... , I hereby certify that the within instrument was filed in this office
for record on the..20th day of...January..... , 19..81
..... by
(COUNTY OFFICIAL) (DEPUTY)

FILED Jan 20 1981
BAKER COUNTY SURVEYOR
SURVEY NO. 10-35-110