


CERTIFIED RECORD OF LAND CORNER MONUMENTATION

Index File No. Q-16

History of original corner establishment:

None.

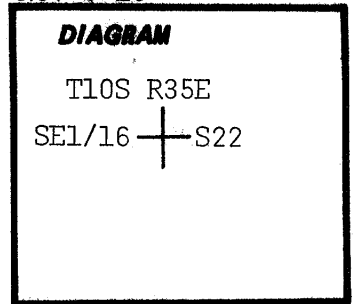

Description of corner evidence found:

None.

Corner falls on open west slope.

Description of monument and accessories | established to perpetuate the original location of this corner:

T10S R35E
SE1/16 + S22
OR PLS 1051
1980



At surveyed point set 2 1/2" X 30" galvanized pipe and brass cap marked: Set pipe 8" in the ground and mound of stone around to cap.

From which by magnetic declination of N20°E: An 8" pine bears N50°E, 68.6 ft. scribed SE1/16S22BT. A 12" juniper bears S75°E, 84.1 ft. scribed SE1/16S22 BT. Painted blazes red and 6" red band around. Placed 54-3s and brass washers stamped PLS 1051 on BTs. Placed 54-2 and 54-9 on steel fence post 5' north and 54-2 on steel fence post 5' east of the corner.

I hereby certify that the above corner monument was reestablished as herein described.

Witnesses: Daniel Rowland
Larry Shirley

August 11, 1980

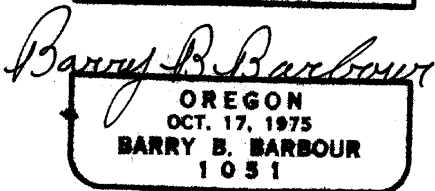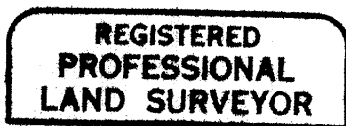

Office of.....County Surveyor.....County of.....Baker
Oregon
State of....., I hereby certify that the within instrument was filed in this office
for record on the...20th day of....January....., 1981.

..... by
(COUNTY OFFICIAL)

(DEPUTY)

Form R6-7100-57 (9/71)

☆ GPO—798-276

FILED Jan 20 1981
BAKER COUNTY SURVEYOR
SURVEY NO. 10-35-112