


CERTIFIED RECORD OF LAND CORNER MONUMENTATION

Index File No. Q-R-11

History of original corner establishment:

None.

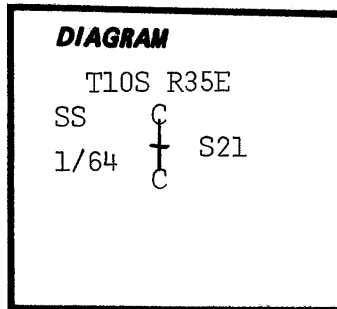

Description of corner evidence found:

None.

Corner falls near ridge at SW corner of small clearing.

Description of monument and accessories I established to perpetuate the original location of this corner:

T10S R35E
SS C
1/64 + S21
 C
OR PLS 1051
1980

At surveyed point set 2 1/2" X 30" galvanized pipe and brass cap marked: Set pipe 14" in the ground and mound of stone around to cap.


From which by magnetic declination of N20°E:

A 15" tamarac bears S39°E, 68.4 ft. scribed Cssl/64S21 BT. A 9" tamarac bears N35°W, 80.5 ft. scribed CSS1/64S21 BT. Painted blazes red and 6" red band around. Placed 54-3s, 54-9s and brass washers stamped PLS 1051 on BTs. Placed 54-2 and 54-9 on steel fence post 5' east of the corner.

I hereby certify that the above corner monument was reestablished as herein described.

Witnesses: Daniel Rowland
Larry Shirley

August 28, 1980

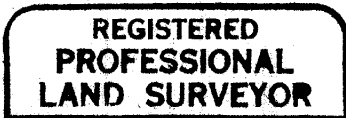

Barry B. Barbour

**OREGON
OCT. 17, 1975
BARRY B. BARBOUR
1051**

Office of.....County Surveyor.....County of.....Baker
State of.....Oregon....., I hereby certify that the within instrument was filed in this office
for record on the 20th day of.....January....., 1981.
.....by.....
(COUNTY OFFICIAL) (DEPUTY)

Form R6-7100-57 (9/71)

☆ GPO—798-276

FILED Jan 20 1981
BAKER COUNTY SURVEYOR
SURVEY NO. 10-35-116