

CERTIFIED RECORD OF LAND CORNER MONUMENTATION

Index File No. R-13

History of original corner establishment:

Corner was originally established by Herman D. Gradon under G.L.O. contract No 416 during October, 1881. Surveyor General's notes state: "Set a basalt stone 12x10x9 ins. 9 ins. in the ground for cor. to secs. 21, 22, 27 and 28 marked with 2 notches on S and 3 notches on E edges; from which: A pine 28 ins. diam bears N25°E, 38 lks. dist. marked T10SR35ES22 BT. A fir 14 ins. diam. bears S45°E, 111 lks. dist. marked T10SR35ES27 BT. A fir 12 ins. diam. bears S10°W, 95 lks. dist. marked T10SR35ES28 BT. A tamarack 15 ins. diam. bears N45°W, 50 lks. dist. marked T10SR35ES21 BT."

DIAGRAM

T10S	R35E
S21	S22
S28	S27

Description of corner evidence found:

Found 14x10x8 inch stone in mound of stone marked with 3 notches on E and 2 notches on S sides. From which: A 32" pine bears N25°E, 25.4 ft. with dim full scribing. All other BTs down.

Description of monument and accessories | established to perpetuate the original location of this corner:

At the center of the above described rock, set 2 1/2" X 30" galvanized pipe and brass cap marked: Set pipe 10" in the ground and mound of stone around to cap. From which by magnetic declination of N 20°E: A 22" Fir bears S65°E, 88.4 ft. scribed T10SR35ES27 BT. An 11" Pine bears S12°W, 84.3 ft. scribed T10SR35ES28 BT. A 12" tamarac bears N74°W, 84.5 ft. scribed T10SR35ES21 BT. Painted blazes red and 6" red band around. Placed 54-3s, 54-4s and brass washers stamped PLS 1051 on BTs. Placed 54-4 on steel fence post 5' East of the corner.


T10S	R35E
S21	S22
S28	S27

OR PLS 1051
1980

I hereby certify that the above corner monument was reestablished as herein described.

Witnesses: Robert Boling
Larry Shirley

July 23, 1980

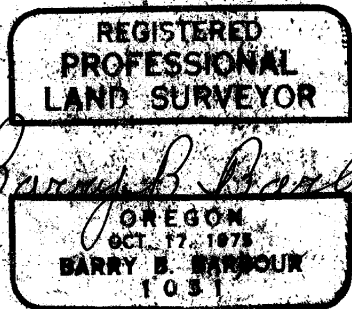

Office of.....County Surveyor..... County of.....Baker.....
State of.....Oregon....., I hereby certify that the within instrument was filed in this office
for record on the 20th day of...January....., 1981
..... by
(COUNTY OFFICIAL) (DEPUTY)