

CERTIFIED RECORD OF LAND CORNER MONUMENTATION

Index File No, R-15

History of original corner establishment:

Corner was originally established by Herman D. Gradon under G.L.O. contract No 416 during October, 1881. Surveyor General's notes state: "Set a post 3 1/2 ft. long, 3 ins. square 24 ins. in hte ground for 1/4 sec. cor. marked 1/4S on N. face; from which: A fir 12 ins. diam. bears N55°E, 14 lks. dist. marked 1/4S BT. A fir 14 ins. diam. bears S15°E, 46 lks. dist. marked 1/4S BT."

DIAGRAM

T10S R35E
S22
1/4 ———
S27

Description of corner evidence found:

Found 2 1/2" square wood post, 12" not rotten and 7 rotten inches in the ground and rotten wood 24" in the ground and pointed tip. From which: A 24" White Fir bears N63°E, 9.5 ft. with grown over blaze. A 32" White Fir bears S18°E, 30.5 ft. with opened blaze and scribed BT.

Description of monument and accessories | established to perpetuate the original location of this corner:


T10S R35E
S22
1/4 ———
S27
OR PLS 1051
1980

At the center of the above described point, set 2 1/2" X 30" galvanized pipe and brass cap marked; Set pipe 26" in the ground. No rock in the area. From which by magnetic declination on N20°E: An 18" tamarac bears S53°E, 38.9 ft. scribed 1/4S27 BT. Placed 54-3, 54-4 and brass washers stamped PLS 1051 on BTs. Placed 54-2 nad 54-4 on steel fence post 5' East and 54-2 on steel fence post 5' North of the corner.

I hereby certify that the above corner monument was reestablished as herein described.

Witnesses: Robert Boling
Larry Shirley

July 23, 1980

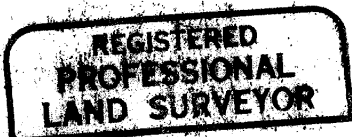

Barry B. Barbour
OREGON
OCT. 17, 1978
BARRY B. BARBOUR
1051

Office of...County Surveyor..... County of...Baker.....
State of...Oregon....., I hereby certify that the within instrument was filed in this office
for record on the 20th day of...January....., 1981

..... by
(COUNTY OFFICIAL)

(DEPUTY)

FILED Jan 20 1981
BAKER COUNTY SURVEYOR
SURVEY NO. 10-35-121