


CERTIFIED RECORD OF LAND CORNER MONUMENTATION

Index File No R-16-17

History of original corner establishment:

None.

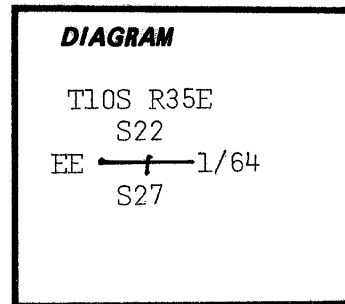

Description of corner evidence found:

Not Set.

Description of monument and accessories I established to perpetuate the original location of this corner:

At survey point set 2 1/2" X 30" galvanized pipe and brass cap marked: Set pipe 22" in the ground and mound of stone around to cap.

From which by magnetic declination of N20°E:

An 11" pine bears N52°W, 70.1 ft. scribed EE1/64 S22 BT.


A 12" fir bears S16°E, 70.8 ft. scribed EE1/64 S27 BT. Painted blazes red and 6" red band around. Placed 54-3s and brass washers stamped PLS 1051 on BTs. Placed 54-2 and 54-9 on steel fence post 5' west and 54-2 on steel fence post 5' north of the corner.

T10S R35E
S22
EE ——— 1/64
S27
OR PLS 1051
1980

I hereby certify that the above corner monument was reestablished as herein described.

Witnesses: Daniel T. Rowland
Larry Shirley

August 6, 1980

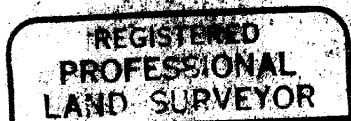

Barry B. Barbour
OREGON
OCT. 17, 1975
BARRY B. BARBOUR
1051

Office of.....County..Surveyor..... County of.....Baker.....
State of.....Oregon....., I hereby certify that the within instrument was filed in this office
for record on the 20th day of.....January....., 1981.

..... by
(COUNTY OFFICIAL) (DEPUTY)

FILED Jan 20 1981
BAKER COUNTY SURVEYOR
SURVEY NO. 10-35-122