


CERTIFIED RECORD OF LAND CORNER MONUMENTATION

Index File No. R-23

History of original corner establishment:

Corner was originally established by Herman D. Gradon under GLO contract No. 416 during October 1881. Surveyors General's notes state. "Set a basalt stone 16x8x6 ins., 11 ins. in the ground for 1/4 sec. cor. marked 1/4 on N. face: from which: A pine 8 ins. diam. bears N25°W, 10 lks. dist. marked 1/4S BT. A pine 24 ins. diam. bears S25°E, 9 lks. dist. marked 1/4S BT."

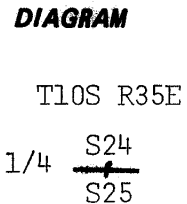

Description of corner evidence found:

Found 16x11x9 inch stone laying loose near 38" pine recently opened with visible scribing. North BT now stump. Measured 11.7 ft. from approx. faces of both trees N25°W, 6.2 ft. from a 38" pine and S25°E, from 18" lodgepole pine stump. 5.5 ft.

Description of monument and accessories established to perpetuate the original location of this corner:

At the above point set 2 1/2" X 30" galvanized pipe and brass cap marked: Set pipe 14" in the ground and mound of stone around to cap. Placed marked stone alongside pipe.

From which by magnetic declination of N20°E;


A 12" pine bears S57°E, 67.3 ft. scribed 1/4S25 BT. A 16" pine bears N17°E, 52.4 ft. scribed 1/4S24 BT. Painted blazes red and 6" red band around. Placed 54-3s, 54-4s and brass washers stamped PLS 1051 on BTs. Old BTs are tagged. Placed 54-4 on steel fence post 5' east of the corner.

T10S R35E
S24
1/4 $\frac{+}{+}$
S25
OR PLS 1051
1980

I hereby certify that the above corner monument was reestablished as herein described.

Witnesses: Daniel Rowland
Doug Moser

October 22, 1980

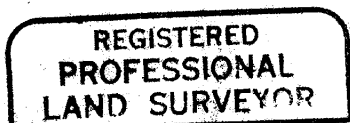

Barry B. Barbour
OREGON
OCT. 17, 1975
BARRY B. BARBOUR
1051

Office of...County Surveyor..... County of...Baker
State of...Oregon....., I hereby certify that the within instrument was filed in this office
for record on the 20th day of January....., 1981.
..... by
(COUNTY OFFICIAL) (DEPUTY)

FILED Jan 20 1981
BAKER COUNTY SURVEYOR
SURVEY NO. 10-35-125