


CERTIFIED RECORD OF LAND CORNER MONUMENTATION

Index File No. T-21

History of original corner establishment:

Corner was originally established by Herman D. Gradon under G.L.O. contract No. 416 during October, 1881. Surveyor General's notes state: "Set a basalt stone 16x8x8 ins., 11 ins. in the ground for 1/4 sec. cor. marked 1/4 on W face: from which: A tamarac 12 ins. diam. bears S60°E, 19 lks. diat. marked 1/4S BT. A Fir 6 ins. diam. bears N45°W, 9 lks. dist. marked 1/4S BT."

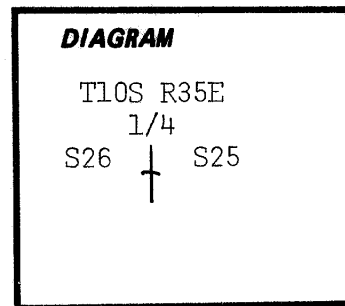

Description of corner evidence found:

Found 15x10x9 inch stone loosely set and marked 1/4 on west side, from which an 18" White Fir bears N76°W, 5.9 ft. with grown over blaze. A rotten 18" tamarac stump bears S65°E, 12.5 ft. No scribing.

Corner is about 100' west of road.

Description of monument and accessories | established to perpetuate the original location of this corner:


T10S R35E
1/4
S26 + S25
OR PLS 1051
1980

At the center of the above stone, set 2 1/2" X 30" galvanized pipe and brass cap marked: Set pipe 25" in the ground and mound of stone around to cap. Placed marked stone at base of pipe. From which by magnetic declination of N20°E: A 14" Fir bears S73°E, 66.5 ft. scribed 1/4S25 BT. Placed 54-3, 54-4 and brass washers stamped PLS 1051 on BTs. Old BTs are signed. Placed 54-4 on steel fence post 5' North of the corner.

I hereby certify that the above corner monument was reestablished as herein described.

Witnesses: Robert Boling
Larry Shirley

July 21, 1980

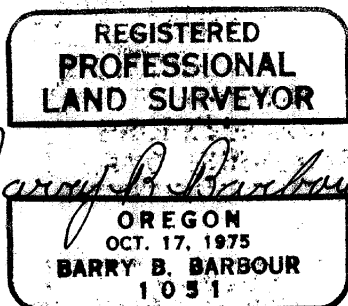

Office of.....County..Surveyor..... County of..... Baker
State of.....Oregon....., I hereby certify that the within instrument was filed in this office
for record on the...20th day of....January....., 1981.
..... by
(COUNTY OFFICIAL) (DEPUTY)