

CERTIFIED RECORD OF LAND CORNER MONUMENTATION

Index File No. V-21

History of original corner establishment:

Corner was originally establishe by Herman D Gradon under GLO contract No. 416 during October, 1881. Surveyor General's notes state: "Set a post 4 ft. long, 4 ins. square, 24 ins. in the ground for cor. to secs. 25, 26, 35, and 36 marked: T10S - S25 on NE, R35E - S36 on SE, S35 on SW and S26 on NW faces, with 1 notch on S and E edges, from which: A cottenwood 12 ins. diam. bears N10°E, 180 lks. dist marked T10S R35E S25 BT. A black pine 8 ins. diam. bears S10°E, 296 lks. dist. marked T10S R35E S36 BT. A quaking asp 14 ins. diam. bears S20°W, 256 lks. dist. marked T10S R35E S26BT."

DIAGRAM

T10S	R35E
S26	S25
S35	S36

Description of corner evidence found:

Found no trace of record post or bearing trees.

Description of monument and accessories | established to perpetuate the original location of this corner:

At surveyed point set 2 1/2" X 30" galvanized pipe and brass cap marked: Set pipe 24" in the ground and mound of stone around to cap. From which by magnetic declination of N20°E: A 16" fir bears S40°E, 236.3 ft. scribed T10SR35ES25 BT. A 12" white fir bears S07°E, 219.7 ft. scribed T10SR35ES36 BT. A 16" tamarac bears S26°W, 134.7 ft. scribed T10S R35ES35E BT. A 14" tamarac bears N04°W, 256.1 ft. scribed T10SR35ES26BT. Trees measured by EDM. Painted blazes red and 6" red band around. Placed 54-3s, 54-4s and brass washers stamped PLS 1051 on BTs. Placed 54-2 and 54-4 on steel fence post 5' east and 54-2 on steel fence post 5' south of the corner.


T10S	R35E
S26	S25
S35	S36

OR PLS 1051
1980

I hereby certify that the above corner monument was reestablished as herein described.

Witnesses: Daniel Rowland
Larry Shirley

September 8, 1980

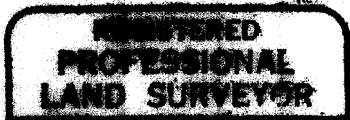

Office of.....County Surveyor.....County of.....Baker.....
State of.....Oregon....., I hereby certify that the within instrument was filed in this office
for record on the 20th day of January, 1981.
..... by
(COUNTY OFFICIAL) (DEPUTY)

FILED Jan 20 1981
BANKER COUNTY SURVEYOR
SURVEY NO. 10-35-128