

# **CERTIFIED RECORD OF LAND CORNER MONUMENTATION**

Index File No. V-25

## **History of original corner establishment:**

Corner was originally established by Herman D. Gradon under G.L.O. contract No 416 during September, 1881. Surveyor General's notes state: "A point about 400 ft. below top of hill; Set a post 4 ft. long, 4 ins. square 24 ins. in the ground fro cor. to secs. 25,36, 30 and 31 marked: T10S S30 on N.E., R36E S31 on S.E., R35E S36 on S.W., and S25 on N.W. faces, with 1 notch on S and 5 notches on N edges; from which: A black pine 6 ins. diam. bears N20°E, 30 lks. dist. marked T10SR35ES30 BT. A black pine 4 ins. diam. bears S60°E, 9 lks. dist. marked T10SR36ES31 BT. A black pine 12 ins. diam. bears S20°W, 8 lks. dist. marked T10SR35ES36 BT. A black pine 6 ins. diam. bears N65°W, 21 lks. diat. marked T10SR35ES25 BT."

## **DIAGRAM**

T10S	
R35E	
S25	R351/2E
S36	S28

## **Description of corner evidence found:**

Found no trace of wood post. From rotten stump, measured N20°E, 5.3 ft. Then measured N20°E, 19.7 ft. to de-faced 10" dead lodgepole pine. No trace of SE BT. Measured N65°W, 13.5 ft. and found stump hole of down and rotten pine. Found piece on ground with readable BT.

## **Description of monument and accessories | established to perpetuate the original location of this corner:**

At the above point set 2 1/2" X 30" galvanized pipe and brass cap marked: Set pipe 24" in the ground and mound of atone around to cap.


From which by magnetic declination of N20°E: A 14" Fir bears S51°W, 23.2 ft. scribed T10SR35ES36 BT. A 12" tamarac bears N68°W, 41.4 ft. scribed T10SR35ES25 BT. Painted blazes red and 6" red band around. Placed 54-3s, 54-4s and brass washers stamped PLS 1051 on BTs. Placed 54-4 on steel fence post 5' East of the corner.

T10S	
R35E	
S25	R351/2E
S36	S28

I hereby certify that the above corner monument was reestablished as herein described.

Witnesses: Robert Boling  
Larry Shirley

July 22, 1980

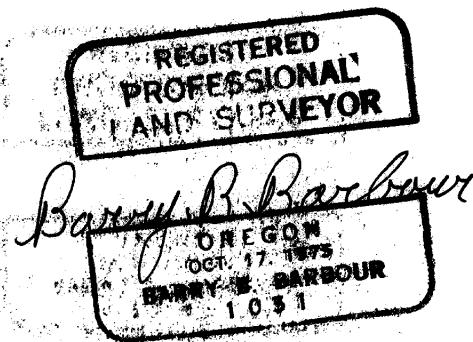

Office of.....County..Surveyor..... County of.....Baker.....  
State of.....Oregon....., I hereby certify that the within instrument was filed in this office  
for record on the 20th day of...January....., 19.81  
..... by .....  
(COUNTY OFFICIAL) (DEPUTY)

Form R6-7100-57 (9/71)

FILED Jan 20 1981  
BAKER COUNTY SURVEYOR  
SURVEY NO. 10-35-130