


CERTIFIED RECORD OF LAND CORNER MONUMENTATION

Index File No. W- 23

History of original corner establishment:

None.

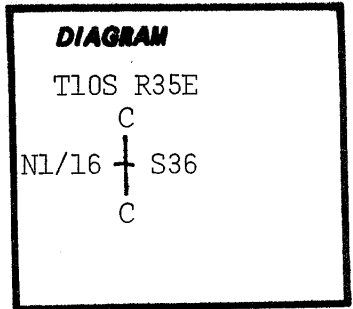

Description of corner evidence found:

None.

Corner falls in the SE corner of Howard Meadows.

Description of monument and accessories | established to perpetuate the original location of this corner:

At surveyed point set 2 1/2" X30" galvanized pipe and brass cap marked: Set pipe 10" in the ground and mound of stone around to cap.

From which by magnetic declination of N20°E: A 10" lodgepole pine bears S26°E, 41.0 ft. scribed SN1/16S36BT.


An 8" lodgepole pine bears S33°W, 48.7 ft. scribed CN1/16S36 BT. Painted blazes red and 6" red band around. Placed 54-3s, 54-9s and brass washers stamped PLS 1051 on BTs. Placed 54-2 and 54-9 on steel fence post 5' north and 54-2 on steel fence post 5' west of the corner.

T10S R35E
C
N1/16 + S36
C
OR PLS 1051
1980

I hereby certify that the above corner monument was reestablished as herein described.

Witnesses: Daniel Rowland
Larry Shirley

September 8, 1980

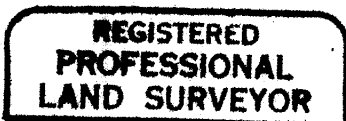

Barry B. Barbour
**OREGON
OCT. 17, 1975
BARRY B. BARBOUR
1051**

Office of.....County Surveyor..... County of..Baker.....
State of.....Oregon....., I hereby certify that the within instrument was filed in this office
for record on the 20th day of.....January....., 1981

..... by
(COUNTY OFFICIAL) (DEPUTY)

Form R6-7100-57 (9/71)

☆ GPO—798-276

FILED Jan 20 1981
BAKER COUNTY SURVEYOR
SURVEY NO. 10-35-132