


CERTIFIED RECORD OF LAND CORNER MONUMENTATION

Index File No. X-23

History of original corner establishment:

None.

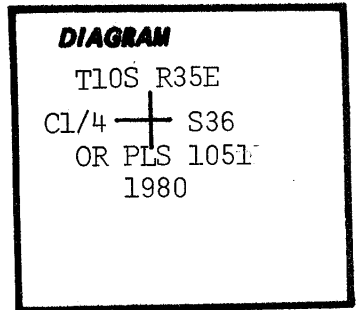

Description of corner evidence found:

None.

Description of monument and accessories established to perpetuate the original location of this corner:

T10S R35E
C1/4 —+— S36
OR PLS 1051
1980

At surveyed point set 2 1/2" X 30" galvanized pipe and brass cap marked: Set pipe 25" in the ground and mound of stone around to cap.
From which by magnetic declination of N20°E: A 9" pine bears S32°E, 65.9 ft. scribed C1/4S36 BT. A 15" White fir bears N35°W, 53.6 ft. scribed 1/4S36 BT. Painted blazes red and 6" red band around. Placed 54-3s, 54-9s and brass washers stamped PLS 1051 on BTs. Placed 54-9 on steel fence post 5' east of the corner.

I hereby certify that the above corner monument was reestablished as herein described.

Witnesses: Daniel Rowland
Larry Shirley

September 8, 1980



Barry B. Barbour
OREGON
OCT. 17, 1975
BARRY B. BARBOUR
1051

Office of...County Surveyor..... County of...Baker.....
State of...Oregon....., I hereby certify that the within instrument was filed in this office
for record on the...20th day of...January....., 1981.
..... by
(COUNTY OFFICIAL) (DEPUTY)

Form R6-7100-57 (9/71)

☆ GPO—798-276

FILED Jan 20 1981
BAKER COUNTY SURVEYOR
SURVEY NO. 10-35-134