

CERTIFIED RECORD OF LAND CORNER MONUMENTATION

Index File No. E-23

History of original corner establishment:

Corner was originally established by Herman D. Gradon under GLO contract No. 416 during October, 1881. Surveyors General notes state: "Set a basalt stone 18x10x4 ins. 12 ins. in the ground for 1/4 sec. cor. marked 1/4 on N. face; from which a Pine 30 ins. diam bears N50E, 87 lks dist. marked 1/4S BT.

DIAGRAM

T10S R35E
S1

1/4 ———

S12

Description of corner evidence found:

Found 20 x 9 x 4 inch stone set in small mound of stone marked 1/4 on north face. From which a 28" pine stump bears N04°E, 58.2 ft. No scribing due to cut low. Stump hole S15°E, 12.0 ft.

Description of monument and accessories I established to perpetuate the original location of this corner:

At center of the above stone, set 2 1/2" X 30" galvanized pipe and brass cap marked: Set pipe 10" in the ground and mound of stone around to cap. Placed marked stone alongside. From which by magnetic declination of N20°E:

A 15" Pine bears S77°W, 33.5 ft. scribed 1/4 S12 BT.

A 20" Fir bears N25°W, 75.0 ft. scribed 1/4 S1 BT.

Painted blazes red and 6" red band around. Placed 54-3s, 54-4s and brass washers stamped PLS 1051. Placed 54-4 on a steel fence post 5' west of the corner.

T10S R35E
S1


1/4 ———

S12
OR PLS 1051
1981

I hereby certify that the above corner monument was reestablished as herein described.

Witnesses: Daniel Rowland

June 30, 1981

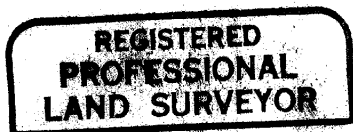

Barry B. Barbour
OREGON
OCT. 17, 1975
BARRY B. BARBOUR
1031

Office of.....County Surveyor.....County of.....Baker.....
State of.....Oregon....., I hereby certify that the within instrument was filed in this office
for record on the 20.... day of.....July....., 1981
..... by *Thomas J. Hamley*.....
(COUNTY OFFICIAL) (DEPUTY)

FILED July 20, 1981
BAKER COUNTY SURVEYOR
SURVEY NO. 10-35-136