

CERTIFIED RECORD OF LAND CORNER MONUMENTATION

Index File NO. J-23

History of original corner establishment:

Corner was originally established by Herman D. Gradon under G.L.O. contract No. 416 during October, 1881. Surveyors General's notes state: "Set a post 3 ft. long 3 ins. square 24 ins. in the ground for 1/4 sec. cor. marked 1/4S on N. face: from which a fir 12 ins. diam. bears N05°E., 15 lks. dist. marked 1/4S BT. A black pine 8 ins. diam. bears S10°E., 12 lks. dist. marked 1/4S BT.

DIAGRAM

M
S12
1/4 —
S13

Description of corner evidence found:

Found 2" brass cap on a 1" pipe from which a 12" lodgepole pine bears S10°E., 8.3 ft. with visible scribing. Cap marked: Pipe projects 16" above the ground. Built mound of stone around to cap.

M
S12
1/4 —
S13
1968
ORLS 699


Description of monument and accessories established to perpetuate the original location of this corner:

From which by magnetic declination of N20°E:
A 14" fir bears N51°E., 23.1 ft. scribed 1/4 S12 BT.
Painted blazes red and 6" red band around. Placed 54-3s, 54-4 and brass washers stamped PLS 1051 on BTs.
Old BT. is signed. Placed 54-4 on a steel fence post 5' east of the corner.

I hereby certify that the above corner monument was reestablished as herein described.

Witnesses: Daniel Rowland
Troy Phillips

July 7, 1981

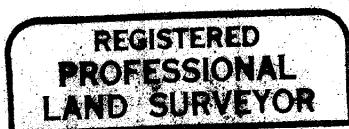

Barry B. Barbour
OREGON
OCT. 17, 1975
BARRY B. BARBOUR
1051

Office of.....County Surveyor..... County of...Baker.....
State of...Oregon....., I hereby certify that the within instrument was filed in this office
for record on the 20.... day of July....., 1981
..... by *Thomas J. Hamley*.....
(COUNTY OFFICIAL) (DEPUTY)

FILED July 20, 1981
BAKER COUNTY SURVEYOR
SURVEY NO. 10-35-139