

CERTIFIED RECORD OF LAND CORNER MONUMENTATION

Index File No. L-21

History of original corner establishment:

Corner was originally established by Herman D, Gradon Under G.L.O. contract No. 416 during October, 1881. Surveroy's General's notes state: "Set a basalt stone 16x8x6 ins. 11 ins. in the ground for 1/4 sec. cor. marked 1/4 on W. face: from which A black pine 6 ins. diam. bears N85°E., 59 lks. dist. marked 1/4S BT. A black pine 7 ins. diam. bears S15°W., 47 lks. dist. marked 1/4S BT.

DIAGRAM

M
1/4
S14 + S13
1968
ORLS 699

Description of corner evidence found:

Found brass cap on 1" pipe. Found no trace of record stone or BTs. Brass cap marked: Pipe projects 10" above the ground. Built mound of stone around to cap.

M
1/4
S14 + S13
1968
ORLS 699


Description of monument and accessories | established to perpetuate the original location of this corner:

From which by magnetic declination of N20°E:
A 24" Tamarac bears S87°E., 172.3 ft. scribed 1/4 S13 BT.
A 21" Tamarac bears S82°W., 166.2 ft. scribed 1/4 S14 BT.
Painted blazes red and 6" red band around. Placed 54-3s, 54-4s and brass washers stamped PLS 1051 on BTs. Placed 54-4 on steel fence post 5' north of the corner.

I hereby certify that the above corner monument was reestablished as herein described.

Witnesses: Daniel Rowland
Troy Phillips

July 7, 1981

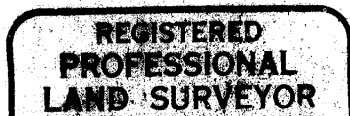

Barry B. Barbour
OREGON
OCT. 17, 1975
BARRY B. BARBOUR
1051

Office of...County Surveyor..... County of...Baker.....
State of...Oregon....., I hereby certify that the within instrument was filed in this office
for record on the...20... day of...July....., 19..81
..... by *Thomas J. Hamley*.....
(COUNTY OFFICIAL) (DEPUTY)

FILED July 20, 1981
COUNTY SURVEYOR
SURVEY NO. 10-35-141