

CERTIFIED RECORD OF LAND CORNER MONUMENTATION

Index File No. N-21

History of original corner establishment:

Corner was originally established by Herman D. Gradon under G.L.O. contract No. 416 during September of 1881. Surveyors General's notes state: "Set a basalt stone 14x10x8 ins. 9 ins. in the ground for cor. to sec.s 13, 14, 23 & 24 marked with 3 notches on S. and 1 notch on E. edges; from which a 10 ins. black pine 12 ins. diam. bears N45°E., 235 lks. dist. marked T10SR35ES13 BT. A black pine 10 ins. diam. bears S35°E., 234 lks. dist. marked T10SR35ES24 BT. A black pine 12 ins. diam. bears S44°W., 252 lks. dist. marked T10SR35ES23 BT. A black pine 12 ins. diam. bears N40°W. 163 lks. dist. marked T10SR35ES14 BT.

DIAGRAM

```

      T10S
      F35E
    S14  S13
      +
    S23  S24
    
```

Description of corner evidence found:

Found brass cap on 1" pipe in mound of stone around pipe. Found 14x9x6 inch stone with 3 notches on one side and 1 notch on the other side. Placed marked stone near date with 3 notches showing. Cap marked: Cap projects 8" above ground with mound of stone around to cap. No trace of original BTs.

```

      T10S
      R35E
    S14  S13
      +
    S23  S24
      1968
    ORLS 699
    
```


Description of monument and accessories | established to perpetuate the original location of this corner:

From which by magnetic declination of N20°E., I add:
 A 45" pine bears N41°E., 224.4 ft. scribed T10SR35ES13 BT.
 A 28" pine bears S24°E., 132.7 ft. scribed T10SR35ES24 BT.
 A 24" Fir bears S75°W., 186.4 ft. scribed T10SR35ES23 BT.
 A 10" lodgepole pine bears N43°W., 132.0 ft. scribed T10SR35ES14 BT.
 Painted blazes red and 6" red band around. Placed 54-3s, 54-4s and brass washers stamped PLS 1051 on BTs. Placed 54-4 on steel fence post 5' south of the corner.

I hereby certify that the above corner monument was reestablished as herein described.

Witnesses: Daniel Rowland

July 7, 1981

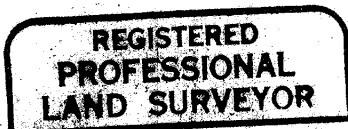

Barry B. Barbour
 OREGON
 OCT. 17, 1975
 BARRY B. BARBOUR
 1051

Office of.....County Surveyor..... County of.....Baker.....
 State of.....Oregon....., I hereby certify that the within instrument was filed in this office
 for record on the..20... day of...July....., 1981.
 by*Thomas J. Hendley*.....
 (COUNTY OFFICIAL) (DEPUTY)

FILED July 20, 1981
 BAKER COUNTY SURVEYOR
 SURVEY NO. 10-35-142