

CERTIFIED RECORD OF LAND CORNER MONUMENTATION

Index File NO. N-23

History of original corner establishment:

Corner was originally established by Herman D. Gradon under GLO contract No. 416 during October, 1881. Surveyors Generals notes state: "Set a post 3 1/2 ft. long 3 ins. square 24 ins in the ground for 1/4 sec. cor. marked 1/4S on N. face: from which a Tamarac 20 ins. diam. bears N15°E., 38 lks dist. Marked 1/4S. BT. A pine 28 ins. diam. bears S5°W., 37 lks dist. marked 1/4S BT.

DIAGRAM

T10S R35E
S13

1/4 ———

S24

Description of corner evidence found:

Found no trace of record wood post. Found dead 24" tamarac with partially opened blaze. Measured S15°W., 25.1 ft. From here a 36" Pine with open blaze and visible scribing bears S05°W., 38.1 ft. A bent pipe and broken cap is east about 4 ft. Pulled pipe.

Description of monument and accessories I established to perpetuate the original location of this corner:

At center of above point set a 2 1/2" X 30" galvanized pipe and brass cap marked: Set pipe 25" in the ground and mound of stone around to cap.

From which by magnetic declination of N20°E:

A 16" Fir bears N56°W., 54.4 ft., scribed 1/4 S13 BT.

Painted blazes red and 6" red band around.

Placed 54-3, 54-4 and brass washers stamped PLS 1051 on BTs.

Old BTs are signed.

Placed 54-4 on a steel fence post 5' west of the corner.

T10S R35E
S13


1/4 ———

S24
OR PLS 1051
1981

I hereby certify that the above corner monument was reestablished as herein described.

Witnesses: Daniel Rowland
Troy Phillips

July 7, 1981

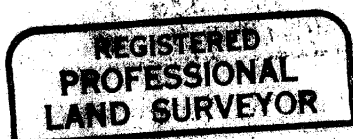

Barry B. Barbour
OREGON
OCT. 17, 1979
BARRY B. BARBOUR
1051

Office of.....County Surveyor..... County of.....Baker.....

State of.....Oregon....., I hereby certify that the within instrument was filed in this office

for record on the...20... day of...July....., 1981

..... by *Thomas J. Hendley*.....
(COUNTY OFFICIAL) (DEPUTY)