


CERTIFIED RECORD OF LAND CORNER MONUMENTATION

Index File No. V-17

History of original corner establishment:

Corner was originally established by Herman D. Gradon under GLO contract No. 416 during October, 1881. Surveyors General's notes state: "Set a basalt stone 14x14x8 ins. 4 ins. in the ground for cor. to secs 26, 27, 34, and 35 marked with 1 notch on S. and 2 notches on E. edges from which a pine 24 ins. diam. bears N40°E. 72 lks. dist. marked T10S R35E S26 BT. A pine 20 ins. diam. bears S25°E. 111 lks. dist. marked T10S R35E. S35 BT. A fir 16 ins diam. bears S75°W. 52 lks dist. marked T10S R35E. S34 BT. A pine 12 ins. diam bears N50°W. 8 lks dist. marked T10S R35E S24 BT.

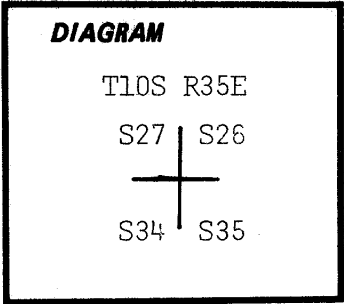


Description of corner evidence found:

From pine measured S50°E. 5.3 ft. Found covered 14" x 12" x 8" stone, with 2 dim notches on one edge. From which a 36" Pine bears N75°E, 49.0 ft. with visible scribing. A 26" Pine bears S25°E, 74.6 ft. with visible scribing. A 24" dead Fir bears S77°W, 35.0 ft. with grown over blaze. A 22" Pine bears N50°E, 5.3 ft. with Visible scribing.


Description of monument and accessories established to perpetuate the original location of this corner:

At the center of the above stone set 2 1/2" X 30" galvanized Pipe and brass cap marked: Set pipe 25" in the ground and mound of stone around to cap. Placed marked stone alongside. From which by magnetic declination of N20°E:
A 24" Fir bears S35°W, 32.0 ft. scribed T10S R35E S34 BT.
Painted blazes red and 6" red band around. Placed 54-3, 54-4, and brass washer stamped PLS 1051. Painted 6" red band around old BTs. BTs have 54-3 and 54-4s
Placed 54-4 on a steel fence post 5' South of the corner.

T10S R35E
S27 | S26
—+—
S34 | S35
OR PLS 1051
1981

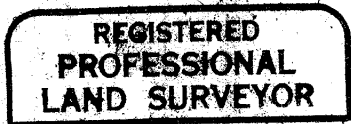

Barry B. Barbour

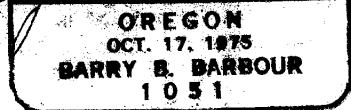

I hereby certify that the above corner monument was reestablished as herein described.

Witnesses: Daniel Rowland

June 29, 1981

Office of.....County Surveyor..... County of.....Baker.....
State of.....Oregon....., I hereby certify that the within instrument was filed in this office
for record on the...20... day of...July....., 1981
..... by *Thomas J. Hanley*.....
(COUNTY OFFICIAL) (DEPUTY)

FILED *July 20, 1981*
COUNTY CLERK
S.E. 1/4, 10-35-146