


CERTIFIED RECORD OF LAND CORNER MONUMENTATION

History of original corner establishment:

Corner was never originally established.

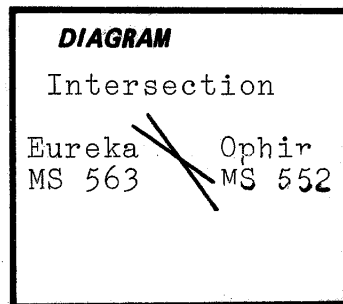

Description of corner evidence found:

None - corner never established.

Description of monument and accessories established to perpetuate the original location of this corner:

At the surveyed corner location, I set 2½" x 30" alum pipe with 2½" alum cap, marked as shown, 24" in the ground and surrounded with a mound of stone from which:

A 9" white fir bears N 19°W -34½ ft.
A 13" white fir bears N 14½°E -25½ ft.


Each blazed and scribed "INTEX-552-563 BT."

Each new bearing tree has a brass washer stamped PLS 1106 nailed to the face of the blaze. Attached sign 54-9 and 54-3 to each bearing tree and painted face of blaze and a 6" red band around each bearing tree. Set steel fence posts on forest boundary south of corner and attached sign 54-2 to both posts and sign 54-9 to one post.

Used steel tape and magnetic staff compass with 20° East declination; measured to center of bearing trees.

This corner was monumented on July 6, 1983.

WITNESS: Kenneth D. Yokom

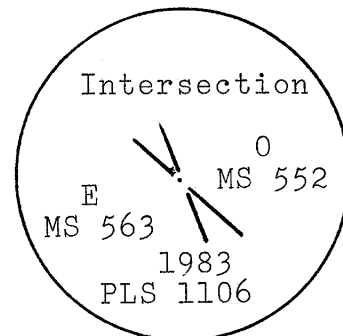

Office of...County Surveyor..... County of...Baker.....
State of...Oregon....., I hereby certify that the within instrument was filed in this office
for record on the..... day of....., 19.....
..... by
(COUNTY OFFICIAL) (DEPUTY)

Form R6-7100-57 (9/71)

FILED Sept. 8, 1983
BAKER COUNTY SURVEYOR
SURVEY NO. 10-35-148