

CERTIFIED RECORD OF LAND CORNER MONUMENTATION

History of original corner establishment:

Corner was originally established by Authur Philbrick in Mineral Survey 546 during January 1904. The original notes state that at the corner a $3\frac{1}{2}$ " long x 4" square marked black pine post was set 18" in the ground and surrounded by a mound of stone from which:

A 10" black pine bears S44°10'W-86.0' marked B.T. P-4-546
A 5" black pine bears N0°45'W35.65' marked B.T. P-4-546

Corner was remonumented by Leland Myers in 1972.

DIAGRAM

Phoenix Cor. 4
MS 546
E
P
Eureka Cor 3
MS 563

Description of corner evidence found:

A loosly set $2\frac{1}{2}$ " alum cap on 1" galv. iron pipe protruding 24" from a mound of stone from which:

A 16" dead l.p. pine bears S44°W-86.0' marked BT P-4-546-X & E-3-563X,
A 13" dead l.p. pine bears N03/4°W35.6' with healed blaze.

Description of monument and accessories | established to perpetuate the original location of this corner:

Set a $2\frac{1}{2}$ "x30" alum pipe with $2\frac{1}{2}$ " alum cap, marked as shown, 20" in the ground and surrounded with a mound of stone from which;

A 10" w. larch bears N30°E-35.5' scribed P-4-546-E-3-563 BT.
A 7" w. larch bears N19½°W-63.6' scribed P-4-X-E-3-X BT.

Buried Myer's monument horizontally beneath stone mound.
Each new bearing tree has a brass washer stamped PLS1106 nailed to the face of the blaze. Attached signs 54-3 and 54-9 and painted face of blaze and a 6" red band around each bearing tree. Set steel fence post northwest and southeast of corner on national forest boundary and attached sign 54-9 to one post and sign 54-2 to both posts.

Used steel tape and magnetic staff compass with 20° east declination.
Measured to center of bearing trees.


This corner was monumented on June 30, 1983.

WITNESS: Ken D. Yokom

REGISTERED
PROFESSIONAL
LAND SURVEYOR

William R. Wells

OREGON
JULY 22, 1977
WILLIAM R. WELLS
1106

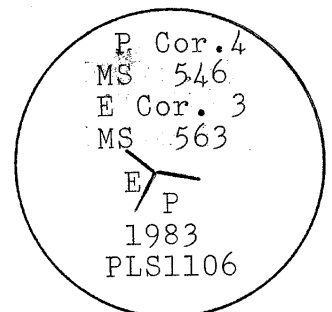

Office of...County...Surveyor..... County of Baker.....
State of...Oregon....., I hereby certify that the within instrument was filed in this office
for record on the..... day of....., 19.....
..... by
(COUNTY OFFICIAL) (DEPUTY)

Form R6-7100-57 (9/71)

FILED Sept. 8, 1983
BAKER COUNTY SURVEYOR
SURVEY NO. 10-35-151

GPO-798-276