


CERTIFIED RECORD OF LAND CORNER MONUMENTATION

History of original corner establishment:

Corner was originally established by Ira. L. Hoffman under Mineral Survey 552 during September 1903. The original notes state that at the corner a 4' long x 6" square marked pine post was set 18" in the ground and surrounded with a mound of earth and stone from which:

A 6" pine bears N63°W-19.1' marked Ophir-8-552-BT.
A 6" pine bears S55°40'W-21.7' marked Ophir-8-552-BT.

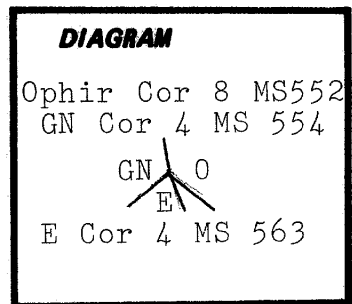

Description of corner evidence found:

The remains of a rotted post in a mound of stone from which;

A 10" dead l.p. pine bears N63½°W-19.1' marked BT-E-2-563 X GN-4-554X.

A 10" dead l.p. pine bears S60°W-21.7' with mostly healed blaze.

Description of monument and accessories I established to perpetuate the original location of this corner:

Set 2½"x30" alum pipe with 2½" alum cap marked as shown, 24" in the ground and surrounded with mound of stone from which;

A 9" w. fir bears N41°E-28.5' scribed 0-8-552-GN-4-554-E-2-563 BT.

A 16" w. larch bears N82°W-49.1' scribed 0-8-552-GN-4-554-E-2-562 BT.

Each new bearing tree has a brass washer stamped PLS1106 nailed to the face of the blaze. Attached signs 54-3 and 54-9 and painted face of blaze and a 6" red ring around each bearing tree. Set a steel fence posts 3-5' away from monument and attached sign 54-9. Placed remains of wood post on stone mound.

Used steel tape and magnetic staff compass with 20° east declination. Measured to center of bearing trees.


This corner was monumented on June 23, 1983.

WITNESS: Robert D. English

REGISTERED
PROFESSIONAL
LAND SURVEYOR

William R. Wells

OREGON
JULY 22, 1977
WILLIAM R. WELLS
1106

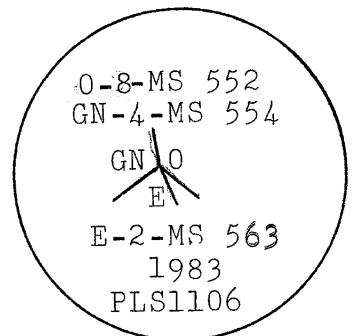

Office of...County...Surveyor..... County of...Baker.....
State of...Oregon....., I hereby certify that the within instrument was filed in this office
for record on the..... day of....., 19.....

..... by
(COUNTY OFFICIAL) (DEPUTY)

Form R6-7100-57 (9/71)

FILED Sept. 8, 1983
BAKER COUNTY SURVEYOR
SURVEY NO. 10-35-153