


CERTIFIED RECORD OF LAND CORNER MONUMENTATION

History of original corner establishment:

The corner was originally established by W. M. Griffin under Mineral Survey No. 552 from September 25-27 of 1903. The original notes state that at the corner a marked pine post 4' long by 4" square was set 18" in the ground, surrounded with a mound of earth and stone.

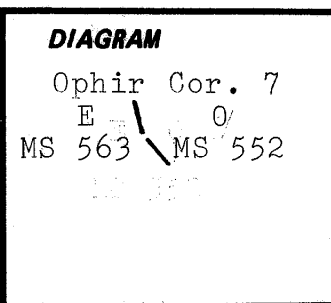


No bearing trees were established.


Description of corner evidence found:

None

Description of monument and accessories established to perpetuate the original location of this corner:

At the surveyed location a 2½" x 30" GIP with 2" B.C., marked as shown, was set 6" below road surface. Placed steel fence post S 34° E 9'± from corner and attached sign 54.9. From the monument:

A 8" Western Larch bears N25½° E 48½ feet.

A 13" Red Fir bears N4° W 55½ feet.


Each blazed and scribed 0-7-552 BT.

Each new bearing tree has a brass washer stamped PLS 1106 nailed to the face of the blaze. Attached signs 54-3 and 54-9 and painted face of blaze and a 6" red band around each bearing tree.



Used steel tape and magnetic staff compass with 20° East declination, measured to the center of the bearing trees.

This corner was monumented on July 6, 1983.

WITNESS: Kenneth D. Yokom

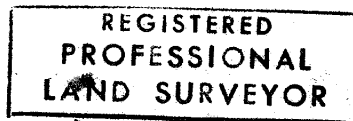

William R. Wells

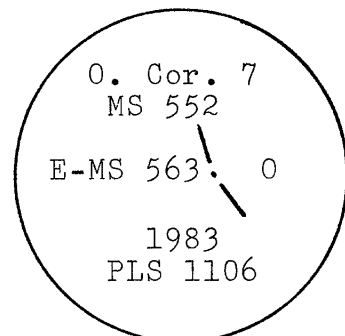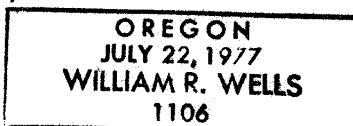

Office of County Surveyor..... County of Baker
State of Oregon....., I hereby certify that the within instrument was filed in this office
for record on the..... day of....., 19.....
..... by
(COUNTY OFFICIAL) (DEPUTY)