


CERTIFIED RECORD OF LAND CORNER MONUMENTATION

History of original corner establishment:

This corner was originally established by Ira L. Hoffman under Mineral Survey No. 552, surveyed from September 25 through September 27, 1903. The original notes state that at the corner a 4' long x 5" square pine post was set 18" in the ground and surrounded with a mound of earth from which"

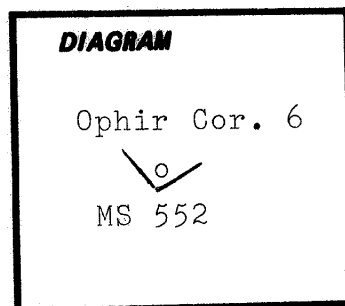

A 8" pine bears N3°25'E-12.2' marked Ophir 6-552-BT.
A 8" pine bears N41°20'W-25.8' marked Ophir 6-552-BT.

This corner was remonumented by Leland Myers in 1972.

Description of corner evidence found:

A 2½" alum cap on 1"x30" flanged pipe protruding 18" from the ground from which"

A 14" dead l.p. pine bears N3½°E-12.5' w/healed blaze (originally bearing tree)
A 11" dead l.p. pine bears N41½°W-26.1' w/scribing visable on partly healed blaze (original bearing tree).

NOTE: Myers had set his monument in the hole containing the original rotted wood post. This resulted in Myers monument being very unstable.

Description of monument and accessories | established to perpetuate the original location of this corner:

A 2½"x30" alum pipe with 2½" alum cap was set 24" in the ground and surrounded with amound of stone from which;

A 7" w. fir bears N52½°W-17.0' scribed 0-6-552-BT.

A 13" w. larch bears N73°E-17.2' scribed 0-6-552-BT.

Each new bearing tree has a brass washer stamped PLS 1106 nailed to the blaze. Attached signs 54-3 and 54-9 and painted face of blaze and a 6" red ring around each bearing tree. Set steel fence posts on national forest boundary lines 3-5' away from corner with signs 54-2 and 54-9 attached to one post and sign 54-2 attached to the other post. Used steel tape and magnetic staff compass with 20°E declination. Measured to center of bearing trees.


This corner was monumented on June 16, 1983.

Witness: Robert D. English

**REGISTERED
PROFESSIONAL
LAND SURVEYOR**

William R. Wells

**OREGON
JULY 22, 1977
WILLIAM R. WELLS
1106**

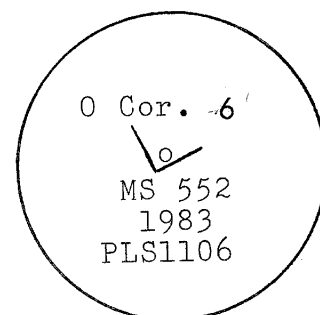

Office of.....County Surveyor.....County of.....Baker
State of.....Baker....., I hereby certify that the within instrument was filed in this office
for record on the..... day of....., 19.....
..... by
(COUNTY OFFICIAL) (DEPUTY)

Form R6-7100-57 (9/71)

FILED Sept. 8, 1983
BAKER COUNTY SURVEYOR
SURVEY NO. 10-35-155

GPO—798-276