


**CERTIFIED RECORD OF LAND CORNER MONUMENTATION**

**History of original corner establishment:**

This corner was originally established by Ira L. Hoffman under Mineral Survey 552, surveyed from September 25 through September 27, 1903. The original notes state that at the corner a 4' long by 4" square pine post was set 18" in the ground and surrounded with a mound of earth and stone from which:

A 8" tamarack bears S37°20'E 15.6' marked Ophir S. End Cen. & 5-552-BT.

This corner was remonumented by Leland Myers in 1972.

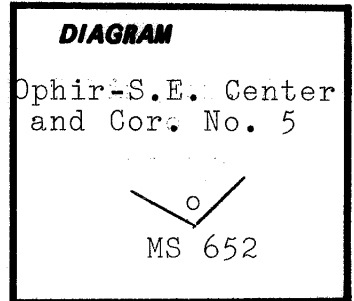

**Description of corner evidence found:**

Monument had been removed and referenced by road staking crews. The bearing tree had been destroyed by road construction. After thorough search, we found the reference pins set in the base of a 12" l.p. pine and a 10" l.p. pine as set out by the crew that referenced Myer's monument.

Using the pins found we re-established the corner by measuring 64.37' from the pin in the root of a 10" l.p. pine and 65.24' from the pin in the root of a 12" l.p. pine.

**Description of monument and accessories I established to perpetuate the original location of this corner:**

At the corner point a 2½"x30" alum pipe with 2½" alum cap, marked as shown, was set 24" in the ground and surrounded with a mound of stone from which:

A 9" r. fir bears S2½°W-51.6' scribed O-SEC- 5-552 BT.  
A 9" r. fir bears S78°W-44.9' scribed O-SEC- 5-552 BT.

Each new bearing tree has a brass washed stamped PLS 1106 nailed to the blaze. Attached signs 54-3 and 54-9 and painted face of blaze and a 6" red ring around each bearing tree.

Set steel fence posts on national forest boundary lines 3-5' away from corner with signs 54-2 and 54-9 attached to one post and sign 54-2 attached to the other post.



Used steel tape and magnetic staff compass with 20° east declination. Measured to center of bearing trees.

This corner was monumented on June 16, 1983.

WITNESS; Robert D. English



*William R. Wells*

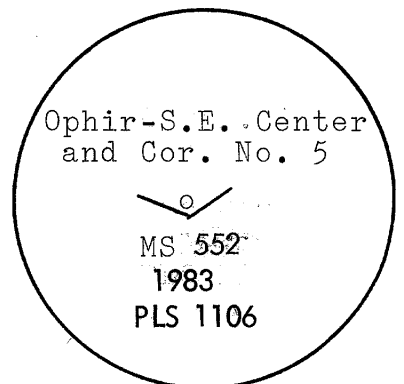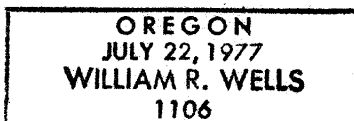

Office of.....County Surveyor..... County of Baker  
State of Oregon....., I hereby certify that the within instrument was filed in this office  
for record on the..... day of....., 19.....  
..... by .....  
(COUNTY OFFICIAL) (DEPUTY)

Form R6-7100-57 (9/71)

FILED Sept. 8, 1983  
BAKER COUNTY SURVEYOR  
SURVEY NO. 10-35-156

GPO-798-276