

NOTES:

ALL BEARINGS AND DISTANCES IN PARENTHESIS ARE RECORD BEARINGS AND DISTANCES. FOR ADDITIONAL INFORMATION ON CORNERS RECOVERED OR MONUMENTED, SEE CERTIFIED RECORD OF LAND CORNER MONUMENTATION FORMS FILED HERewith. FIELD BOOK REFERENCE - TRAVERSE BOOK NO. 3 AND MONUMENTATION BOOKS NO. 1 & 2 OF THE GREENHORN MINES CADASTRAL SURVEY.


SURVEYOR'S CERTIFICATION

I, WILLIAM R. WELLS, A REGISTERED PROFESSIONAL LAND SURVEYOR IN THE STATE OF OREGON, HEREBY CERTIFY, THAT THIS PLAT, AND THE NOTES HEREON, ARE A CORRECT REPRESENTATION OF A SURVEY PERFORMED BY ME DURING THE MONTHS OF JULY AND AUGUST, 1983, AT THE REQUEST OF THE USDA, FOREST SERVICE. SAID PLAT AND NOTES WERE PREPARED IN ACCORDANCE WITH THE STATUTES OF THE STATE OF OREGON AND WITH THE ARTICLES OF THE CONTRACT.

William R. Wells
WILLIAM R. WELLS, PLS
OREGON LICENSE NO. 1106

REGISTERED
PROFESSIONAL
LAND SURVEYOR

William R. Wells
OREGON
JULY 22, 1977
WILLIAM R. WELLS
1106

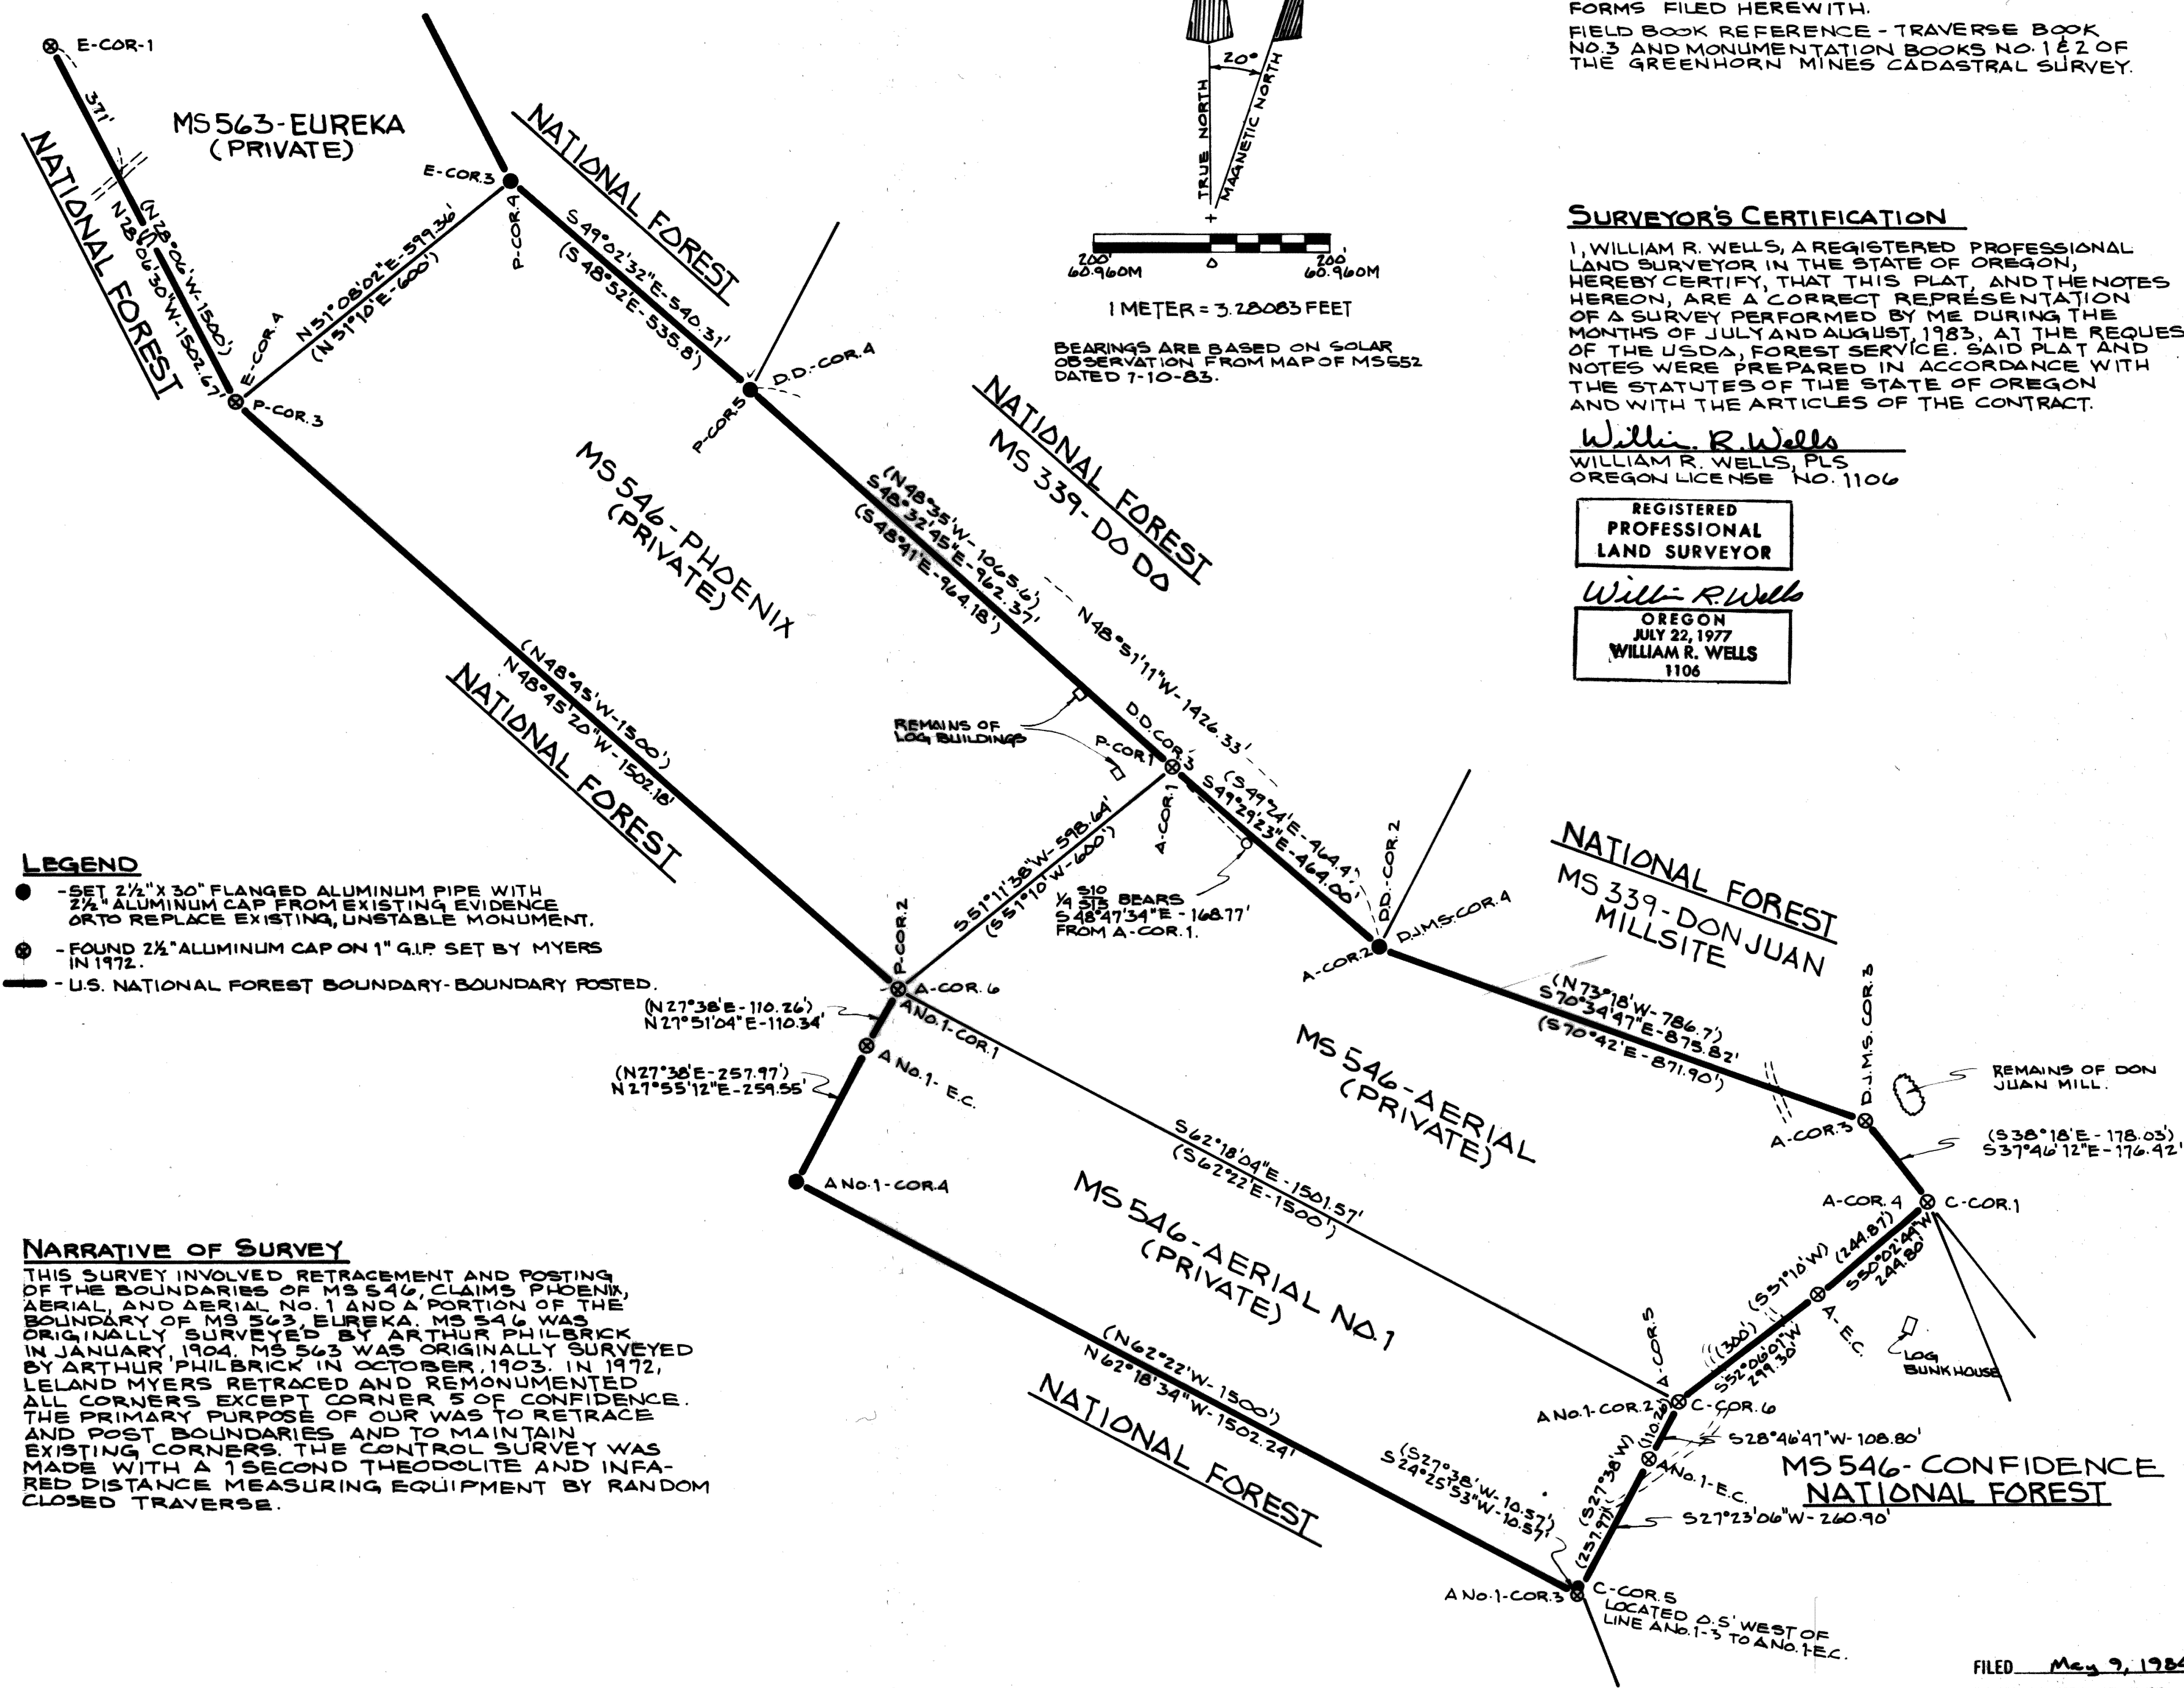

FILED May 9, 1984
BAKER COUNTY SURVEYOR
SURVEY NO. 10-35-158

WALLULIS PROJECT NO:

AGENCY PROJECT NO:

USFS CONTRACT
53-04M3-3-2886
R16-83-11N

PROJECT:

GREENHORN MINES
CADASTRAL SURVEY
WALLOWA - WHITMAN
NATIONAL FOREST

LOCATED IN THE SOUTH 1/2
OF SECTION 10 & NORTH 1/2
OF SECTION 15, T10S, R35E,
W.M., BAKER COUNTY, OREGON.

WALLULIS & ASSOCIATES, INC.
ENGINEERING & PLANNING

PENDLETON, OREGON 97801

503 276 1598

SCALE: 1"=200'

DATE: 7-31-83

DES BY:

DR BY: WRW

CK BY: WRW

TITLE:

MS 546
MS 563

REVISIONS

DRAWING:

SHEET 1 OF 1