

CERTIFIED RECORD OF LAND CORNER MONUMENTATION


History of original corner establishment:

Corner was originally established by Arthur Philbrick under Mineral Survey 546 surveyed in January, 1909. The original notes state that at the corner a 3½" long x 4" square marked pine post was set 18" in the ground with a mound of earth and stone from which:

A 24" red fir bears N53°54'W-78.00' marked BT P-2-A-6-A No. 1-546.

A 30" red fir bears S53°38'W-66.00' marked BT P-2-A-6-A No. 1-1546.

Corner was remonumented by Leland Myers in 1972.

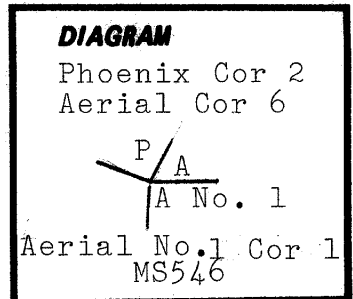

Description of corner evidence found:

Found a 2½" alum cap on 1" galv. iron pipe protruding 12" from a mound of stone, with the remains of the original wood post lying on the ground. From Myer's monument:

A 30" dead red fir bears S53½°W-68.0 feet marked BT A-1-P-2/546X

A 33" white fir bears N55°W-79.1' marked BT A4/546X
A No. 1

Description of monument and accessories I established to perpetuate the original location of this corner:

Mounded additional stones around Myer's monument to stabilize it. From Myer's monument:

A 11" w. fir bears S80°W-31.1' scribed P-2-A-6-A1-1-546 BT.

Each new bearing tree has a brass washer stamped PLS1106 nailed to the face of the blaze. Attached signs 54-3 and 54-9 and painted face of blaze and a 6" red band around each bearing tree. Set steel fence posts on national forest boundary northwest and southwest of corner and attached sign 54-9 to one post and signs 54-2 to both posts.

Used steel tape and magnetic staff compass with 20° east declination. Measured to center of bearing trees.


This corner was maintained on July 1, 1983

WITNESS: Ken D. Yokom

REGISTERED
PROFESSIONAL
LAND SURVEYOR

William R. Wells

OREGON
JULY 22, 1977
WILLIAM R. WELLS
1106

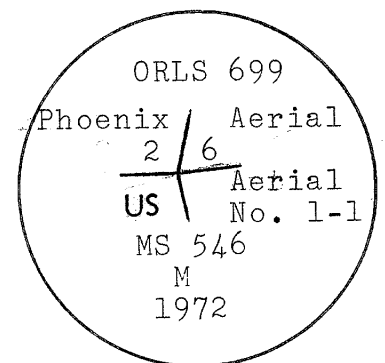

Office of...County...Surveyor..... County of.....Baker.....
State of Oregon....., I hereby certify that the within instrument was filed in this office
for record on the..... day of....., 19.....
..... by
(COUNTY OFFICIAL) (DEPUTY)

Form R6-7100-57 (9/71)

FILED May 9, 1984
BAKER COUNTY SURVEYOR
SURVEY NO. 10-35-159

GPO-798-276