


CERTIFIED RECORD OF LAND CORNER MONUMENTATION

History of original corner establishment:

The corner was originally established by Arthur Philbrick under mineral survey No. 546 from January 7-11 of 1904. The original notes state that at the corner a marked black pine post, 3½' long by 4" square was set 18" in the ground with mound of stone. No bearing trees were set.

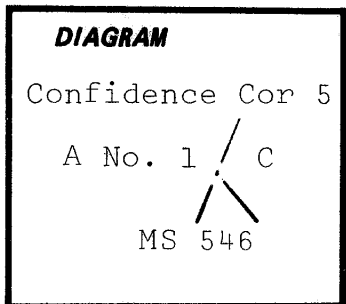

Description of corner evidence found:

Found a mound of stone and remains of rotted post in the hole in center of mound.

Original monumentation

Description of monument and accessories I established to perpetuate the original location of this corner:

At the corner point; a 2½"x30" alum pipe with 2½" alum cap, marked as shown, was set 20" in the ground and surrounded with mound of stone from which:

A 7" lodgepole pine bears N64½°W -22⁵' scribed C-5-546-BT.

A 6" spruce bears S86½°W -11⁹' scribed C-5-546-BT.


Each new bearing tree has a brass washer stamped PLS1106 nailed to the face of the blaze. Attached signs 54-3 and 54-9 and painted face of blaze and a 6" red ring around each bearing tree.

Set steel fence posts Northeast and Southwest of corner and attached signs 54-2 to both posts and sign 54-9 to one post.



Used steel tape and magnetic staff compass with 20° east declination measured to center of bearing trees.

This corner was monumented on July 6, 1983.

WITNESS: Kenneth D. Yokom

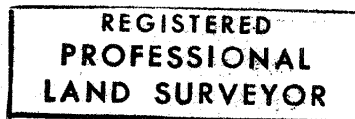

William R. Wells

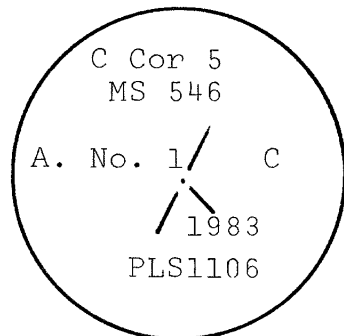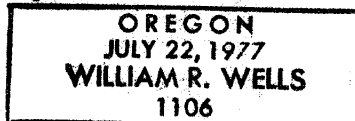

Office of.....County Surveyor..... County of.....Baker
State of Oregon....., I hereby certify that the within instrument was filed in this office
for record on the..... day of....., 19.....

..... by
(COUNTY OFFICIAL) (DEPUTY)

Form R6-7100-57 (9/71)

FILED May 9, 1984

BAKER COUNTY SURVEYOR

SURVEY NO. 10-35-161

☆ GPO—798-276