


CERTIFIED RECORD OF LAND CORNER MONUMENTATION

History of original corner establishment:

The corner was originally established MS 339 but was destroyed by snow slide. Corner re-established in MS 546 Aerial 2 by Arthur Philbrick January 7-11 of 1904. The notes from MS 546 survey state that at the corner a marked fir post 3½' x 4" square, set 18" in the ground with a mound of rock from which:

A red fir 24" in diameter bears N89° 33'E 8.36'.
A red fir 16" in diameter bears S 63° 30'W 18.35 ft.
Each blazed and scribed BT A-2-546.

The corner was remonumented by Leland Myers in 1972.

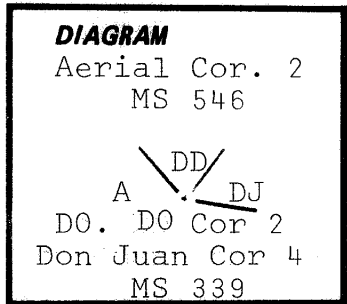

Description of corner evidence found:

Found 2½" alum cap on 1" GIP protruding 24" out of ground with remains of wood post next to monument in which:

A 24" dead red fir snag bears East -9⁶/₁₀ ft. with healed blaze.
A 17" dead and down red fir snag bears S64°W -18⁵/₁₀ ft.

Description of monument and accessories | established to perpetuate the original location of this corner:

At the corner point a 2½"x30" alum pipe with 2½" alum cap, marked as shown, was set 12" in the ground, with Myer's monument buried horizontally; surrounded by a mound of stone from which:

A 19" red fir bears S72¹/₂°E -19³/₁₀ ft. scribed DD-2-DJ-4-339-A-2-546 BT.
A 6" white fir bears S81°W -17⁰/₁₀ ft. scribed DD-2-DJ-4-339-A-2-546 BT.



Each new bearing tree has a brass washer stamped PLS 1106 nailed to the face of the blaze. Attached signs 54-3 and 54-9 and painted face of blaze and a 6" red ring around each bearing tree.

Set steel fence posts Northwest and Southeast of corner and attached signs 54-2 to both posts and sign 54-9 to one post.

Used steel tape and magnetic staff compass with 20° east declination measured to center of bearing trees.

This corner was monumented on July 5, 1983.

WITNESS: Kenneth D. Yokom

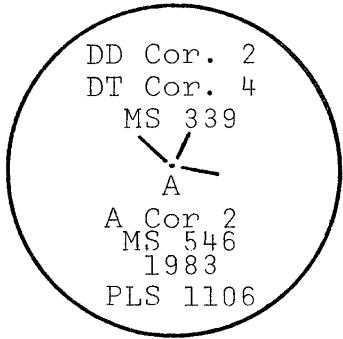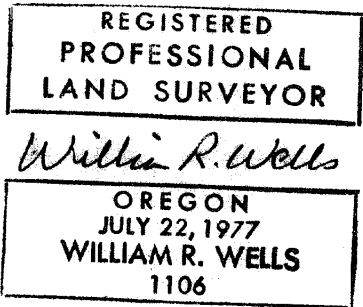

Office of.....County Surveyor..... County of.....Baker.....
State of.....Oregon....., I hereby certify that the within instrument was filed in this office
for record on the..... day of....., 19.....
..... by
(COUNTY OFFICIAL) (DEPUTY)