

CERTIFIED RECORD OF LAND CORNER MONUMENTATION

History of original corner establishment:

Corner was originally established by Arthur Philbrick under Mineral Survey 339 during September 1897. The original notes state that at the corner a 4' long by 4" square marked pine post was set 18" in the ground and surrounded by a mound of stone from which:

A 10" b. pine bears S28°20'E-19.3' marked D.D.-3-339-BT.

A 12" b. pine bears S85°50'W-41.4' marked D.D.-3-339-BT.

A 12" b. pine bears N25°W-39.3' marked D.D.-3-339-BT.

In January 1904, this corner was established as Corner No. 1 of the Aerial and Phoenix Lodes by Arthur Philbrick under MS 546. These original notes state that at the corner a 3½" long by 4" square marked pine post was set 18" in the ground and surrounded by a mound of stone from which:

A 20" black pine bears N35°30'W-57.0' marked BT P-1-546 & BT-A-1-546.

A 20" tamarack bears S18°14'E-30.74' marked BT P-1-546 & BT-A-546.

This corner was remonumented by Leland Myers in 1972.

DIAGRAM

Do Do Cor 3
MS 339

~~D.D.
P/A~~

Phoenix 1
Aerial 1
MS 546

Description of corner evidence found:

A 2½" x 1" galv. iron pipe protruding 12" from a mound of stones from which:

A 20" tamarack stump bears S18°E-31.0' marked 1-A-546 X.

Description of monument and accessories | established to perpetuate the original location of this corner:

We added rocks to the existing monument mound to stabilize corner. From Myer's monument:

A 10" r. fir bears N86°W-19.5' scribed DD-3-339-P-1-A-1-546 BT.

A 10" r. fir bears N67°E-9.2' scribed DD-3-X-P-1-A-1- X BT.

Each new bearing tree has a brass washer stamped PLS 1106 nailed to the face of the blaze. Attached signs 54-3 and 54-9 and painted face of blaze and a 6" red band around each bearing tree. Set steel fence posts on national forest boundary northwest and southeast of corner and attached sign 54-9 to one post and sign 54-2 to both posts.

Used steel tape and magnetic staff compass with 20° east declination. Measured to center of bearing trees.


This corner was maintained on July 1, 1983,

WITNESS: Ken D. Yokom

REGISTERED
PROFESSIONAL
LAND SURVEYOR

William R. Wells

OREGON
JULY 22, 1977
WILLIAM R. WELLS
1106

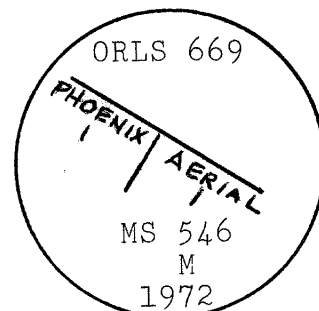

Office of..County...Surveyor..... County of.....Baker.....

State of.....Oregon....., I hereby certify that the within instrument was filed in this office for record on the..... day of....., 19.....

(COUNTY OFFICIAL)

(DEPUTY)

Form R6-7100-57 (9/71)

FILED May 9, 1984

GPO—798-276

BAKER COUNTY SURVEYOR

SURVEY NO. 10-35-164