


CERTIFIED RECORD OF LAND CORNER MONUMENTATION

**History of original corner establishment:**

The corner was originally established by Arthur Philbrick under Mineral Survey 546 from January 7-11 of 1904. The original notes state that at the corner a marked Tamarack post, 4' long x 4" square was set 18" in the ground with mound of rocks from which:

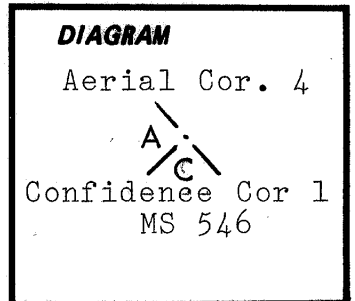

A black pine 12" in diameter bears S 50° 15'W 70.59'. Blazed and scribed BT A-4-546.

The corner was remonumented by Leland Myers in 1972.

**Description of corner evidence found:**

Found 2½"x1" GIP set in mound of stones with remains of a wood post in mound from which:

A pine stump bears S41°W -70.2', with scribing visable on a portion of the bearing tree next to stump.

**Description of monument and accessories | established to perpetuate the original location of this corner:**

The monument set by Myers was stabilized by rock. From Myers' monument:

A 8" spruce bears S71½°E -31½',  
A 8" lodgepole pine bears N87½°E -39½'.

Each scribed A-4-C-1-546 BT.


Each new bearing tree has a brass washer stamped PLS1106 nailed to the face of the blaze. Attached signs 54-3 and 54-9 and painted face of blaze and a 6" red ring around each bearing tree.

Set steel fence posts Northwest and Southwest of corner and attached signs 54-2 to both posts and sign 54-9 to one post.



Used steel tape and magnetic staff compass with 20° East declination measured to center of bearing trees.

This corner was maintained on July 6, 1983.

WITNESS: Kenneth D. Yokom

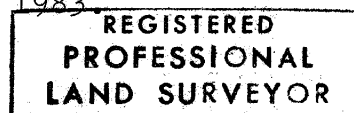

*William R. Wells*

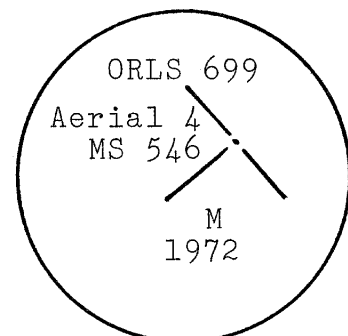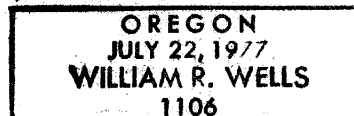

Office of County Surveyor..... County of...Baker.....  
State of....., I hereby certify that the within instrument was filed in this office  
for record on the..... day of....., 19.....  
..... by .....  
(COUNTY OFFICIAL) (DEPUTY)