


CERTIFIED RECORD OF LAND CORNER MONUMENTATION

History of original corner establishment:

The corner was originally established by Arthur Philbrick under mineral survey No. 546 from January 7-11 of 1904. The original notes state that at the corner a marked tamarack post, 4' long by 5" square was set 18" in the ground with a mound of rocks from which:

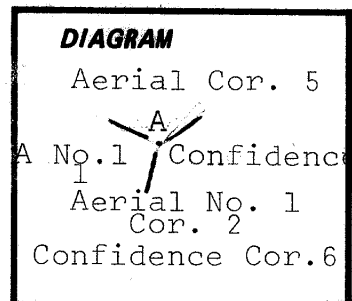

A red fir 20" in diameter, bears N 29° 09' W 83.41'.
A red fir 20" in diameter, bears N 28° 40' E 37.35'.

Each blazed and scribed BTA-5-546.

The corner was remonumented by Leland Myers in 1972.

Description of corner evidence found:

Four 2½" alum cap on 1" GIP protruding 15" from a mound of stone from which:

A 25" dead red fir bears N28½°W -85½°' with an open blaze, scribed BTA-5-546.

Description of monument and accessories | established to perpetuate the original location of this corner:

The monument set by Myers was stabilized by piling rocks from which:

A 13" ponderosa pine bears N51°E -5½'.
A 9" red fir bears S6½°W -40½'.

Each blazed and scribed A-5-A1-2-C-6-546 BT.



Each new bearing tree has a brass washer stamped PLS1106 nailed to the face of the blaze. Attached signs 54-3 and 54-9 and painted face of blaze and a 6" red ring around each bearing tree.

Set steel fence posts Northeast and Southwest of corner and attached signs 54-2 to both posts and sign 54-9 to one post.

Used steel tape and magnetic staff compass with 20° east declination measured to center of bearing trees.

This corner was maintained July 6, 1984.

WITNESS: Kenneth D. Yokom

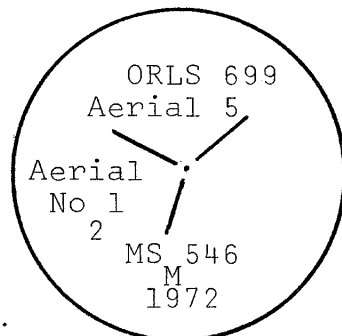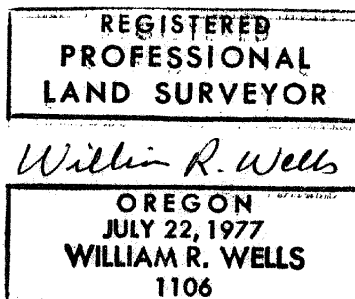

Office of.....County Surveyor..... County of..... Baker
State of..... Oregon....., I hereby certify that the within instrument was filed in this office
for record on the..... day of....., 19.....
..... by
(COUNTY OFFICIAL) (DEPUTY)

Form R6-7100-57 (9/71)

FILED May 9, 1984
BAKER COUNTY SURVEYOR
SURVEY NO. 10-35-167

☆ GPO—798-276