


CERTIFIED RECORD OF LAND CORNER MONUMENTATION

History of original corner establishment:

The corner was originally established by Arthur Philbrick under mineral survey No. 546 from January 7-11 of 1904. The original notes state that at the corner a marked red fir post, 4' long by 4" square was set 18" in the ground with a mound of earth from which:

A red fir 36" in diameter bears N44° 26'E 35.51'.
A red fir 16" in diameter bears S 43° 08'W 21.04'.
Each blazed and scribed BTA-E-C-546.

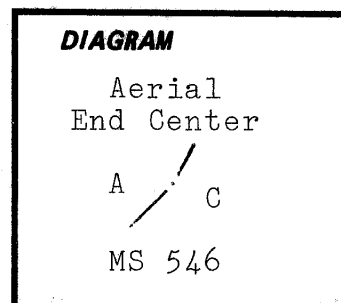

Description of corner evidence found:

Found 2½" alum cap on 1" GIP protruding 15" from mound of stones from which:
A 32" white fir bears S43½°W -20⁶' with healed blaze.

Description of monument and accessories | established to perpetuate the original location of this corner:

The monument set by Myers was stabilized by piling rocks around it.
From Myers' monuments:

A 6" white fir bears S42½°E 21⁶' scribed A-E.C.-564 BT.


Each new bearing tree has a brass washer stamped PLS1106 nailed to the face of the blaze. Attached signs 54-3 and 54-9 and painted face of blaze and a 6" red ring around each bearing tree.

Set steel fence posts Northeast and Southwest of corner and attached signs 54-2 to both posts and sign 54-9 to one post.

Used steel tape and magnetic staff compass with 20° East declination measured to center of bearing trees.

This corner was maintained on July 6, 1983.

WITNESS: Kenneth D. Yokom

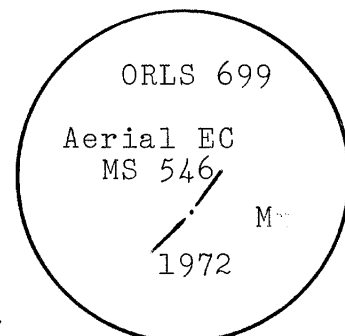

Office of.....County Surveyor..... County of.....Baker.....
State of.....Oregon....., I hereby certify that the within instrument was filed in this office
for record on the..... day of....., 19.....
..... by
(COUNTY OFFICIAL) (DEPUTY)

Form R6-7100-57 (9/71)

FILED May 9, 1984
BAKER COUNTY SURVEYOR
SURVEY NO. 10-35-168