


CERTIFIED RECORD OF LAND CORNER MONUMENTATION

History of original corner establishment:

The corner was originally established by Arthur Philbrick under mineral survey No. 546 from January 7-11 of 1904. The original notes state that at the corner a marked black pine post, 3½' long, 4" square, was set 18" in the ground with a mound of rocks from which:

A tamarack stump 24" diameter bears S61° W 24.79'.
A black pine 6" diameter bears N20° 15' W 41.8'.
Each blazed and scribed BTA No. 1-3-546.

The corner was remonumented by LeLand Myers in 1972.

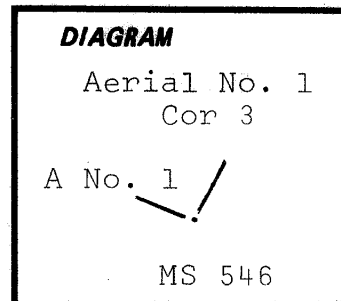

Description of corner evidence found:

Found 2½" alum cap on 1" GIP protruding 15" out of a mound of stone from which:

A 24" tamarack stump bears S62° W -26³/₄'.
A 12" dead lodgepole pine bears N20¹/₄° W -43⁴/₄'.

Description of monument and accessories I established to perpetuate the original location of this corner:

Stabilized monument set by Myers by piling more stones around it, from which:

A 10" western larch bears N61°W 34⁹/₄' scribed A1-3-546 BT.

A 11" western larch bears S18¹/₂°W -25⁰/₄' scribed A1-3-546 BT.



Each new bearing tree has a brass washer stamped PLS1106 nailed to the face of the blaze. Attached signs 54-3 and 54-9 and painted face of blaze and a 6" red ring around each bearing tree.

Set steel fence posts Northwest and Northeast of corner and attached signs 54-2 to both posts and sign 54-9 to one post.

Used steel tape and magnetic staff compass with 20° East declination measured to center of bearing trees.

This corner was maintained July 6, 1983.

WITNESS: Kenneth D. Yokom

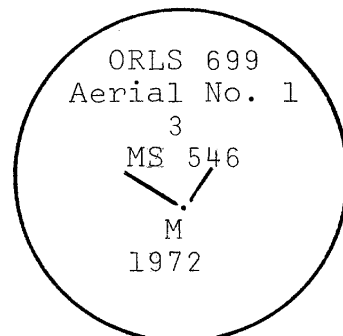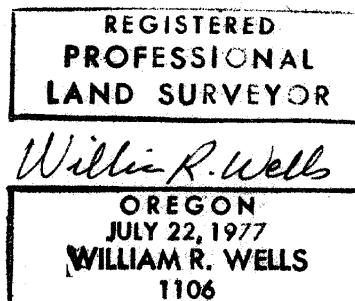

Office of...County Surveyor..... County of...Baker.....
State of...Oregon....., I hereby certify that the within instrument was filed in this office
for record on the..... day of....., 19.....
..... by
(COUNTY OFFICIAL) (DEPUTY)