

CERTIFIED RECORD OF LAND CORNER MONUMENTATION

History of original corner establishment:

The corner was originally established by Arthur Philbrick under mineral survey No. 546 from January 7-11 of 1904. The original notes state that at the corner a marked black pine post 3½' long by 4" square was set 18" in the ground with mound of rocks from which:

A 40" yellow pine bears S83° 10'W -44.63'.
A 35" yellow pine bears S2° 35'W -75.6'.
Each blazed and scribed BTA No. 1 E-C-546.

The corner was remonumented by Leland Myers in 1972.

Description of corner evidence found:

Found 2½" alum cap in 1" GIP protruding 18" out of mound from which:

A 34" ponderosa pine bears S2½° W-76½', healed blaze.
A 40" ponderosa pine bears S83° W-46½' with scribing visable on opened blaze.

Description of monument and accessories | established to perpetuate the original location of this corner:

The monument set by Myers was stabilized with rock; no new bearing trees were established.



Attached signs 54-3 and 54-9 and painted face of blaze and a 6" red ring around each bearing tree.

Set steel fence posts Northeast and Southwest of corner and attached signs 54-2 to both posts and sign 54-9 to one post.



Used steel tape and magnetic staff compass with 20° East declination measured to center of bearing trees.

This corner was maintained on July 6, 1983.

WITNESS: Kenneth D. Yokom

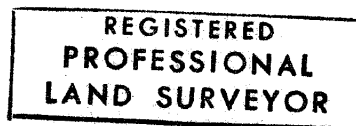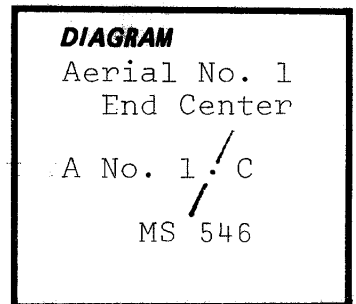

William R. Wells

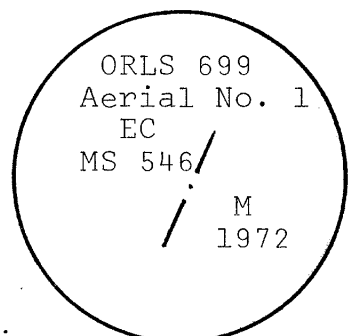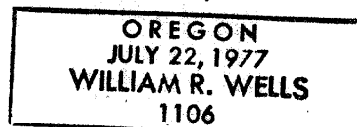

Office of County Surveyor..... County of Baker.....
State of Oregon....., I hereby certify that the within instrument was filed in this office
for record on the..... day of....., 19.....

..... by
(COUNTY OFFICIAL) (DEPUTY)