

CERTIFIED RECORD OF LAND CORNER MONUMENTATION

History of original corner establishment:

The corner was originally established by Charles H. Fenner under mineral survey No. 541 during September 1903. The original notes state that at the corner a 4 1/2' long by 5" square marked fir post was set 18" in the ground and surrounded with a mound of stone from which:

A 24" red fir bears N25°E-13.7' marked B.T. S.C. 4-541.

A 10" red fir bears N80°W-0.60' marked B.T. S.C. 4-541.

DIAGRAM

Snow Creek
Cor. 4



MS 541

No record of subsequent monumentation was found in county records.

Description of corner evidence found:

The remains of a rotted wood post in a mound of stone from which:

A 18" white fir bears N80°W-1.3' with healed blaze.

A 21" red fir bears N25°E-14.4' with visable scribing.

Description of monument and accessories | established to perpetuate the original location of this corner:

A 2 1/2" by 30" aluminum pipe with 2 1/2" aluminum cap was set 15" in the ground and surrounded with a mound of stone from which:

A 10" white fir bears S19°E-47.6' scribed S.C.-4-541 BT.

Each new bearing tree has a brass washer stamped PLS 1106 nailed to the face of the blaze. Attached sign 54-3 and 54-9 to each bearing tree and painted face of blaze and a 6" red band around each bearing tree.


Set steel fence post near monument and attached sign 54-9.

Used steel tape and magnetic staff compass with 20°E declination, measured to the center of the bearing trees.



Cap is marked:

This corner was set on September 29, 1983

Witness: Jim Bowler

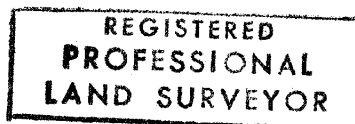

William R. Wells

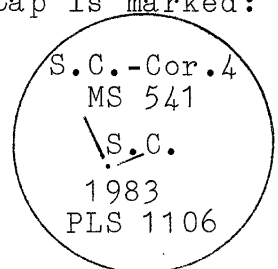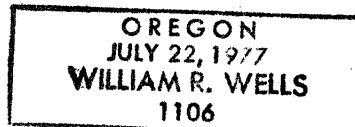

Office of...County Surveyor..... County of...Baker
State of...Oregon....., I hereby certify that the within instrument was filed in this office
for record on the..... day of....., 19.....

..... by

(DEPUTY)

Form R6-7100-57 (9/71)

☆U.S. GOVERNMENT PRINTING OFFICE - 1983-793-276

FILED May 9, 1984

BAKER COUNTY SURVEYOR

SURVEY NO. 10-35-174