


CERTIFIED RECORD OF LAND CORNER MONUMENTATION

History of original corner establishment:

The corner was originally established by Charles H. Fenner under Mineral Survey No. 541 during September 1903. The original notes state that at the corner a 4' long by 4" square marked pine post was set 18" in the ground and surrounded with a mound of stone from which:

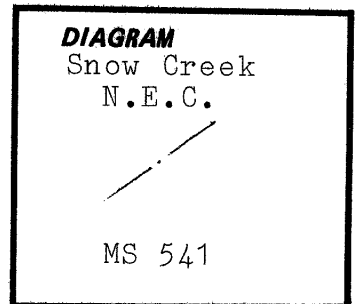

A 9" red fir bears S80°17'E-34.18' marked B.T.S.C. N.C.-541.

A 24" red fir bears S50°20'W-6.30' marked B.T.S.C.N.C.-541.

No evidence of subsequent remonumentation appears in county records.

Description of corner evidence found:

Found original wood post in a stone mound from which:

A 27" red fir bears S51°W-7.3' with visable scribing on partly healed blaze.

Description of monument and accessories I established to perpetuate the original location of this corner:

Set a 2 1/2" by 30" aluminum pipe with 2 1/2" aluminum cap 20" in the ground and surrounded with a mound of stone from which:

A 10" white fir bears N84 1/2°W-19.1' scribed S.C.-N.E.C.-541 BT.

Each new bearing tree has a brass washer stamped PLS 1106 nailed to the face of the blaze. Attached sign 54-3 and 54-9 to each bearing tree and painted face of blaze and a 6" red band around each bearing tree.


Set steel fence post next to monument and attached sign 54-9.

Used steel tape with staff compass with 20°E declination, measured to the center of the bearing trees.



This corner was monumented on October 12, 1983.

Cap is marked:

Witness: Rudy Golbenic

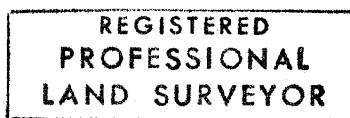

William R. Wells

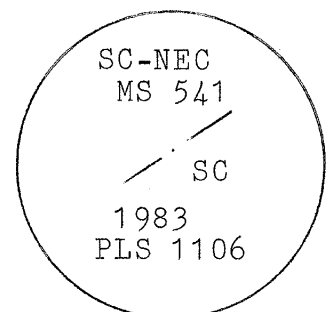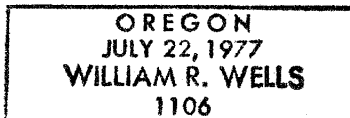

Office of.....County Surveyor..... County of.....Baker.....
State of.....Oregon....., I hereby certify that the within instrument was filed in this office
for record on the..... day of....., 19.....

..... by
(COUNTY OFFICIAL) (DEPUTY)

Form R6-7100-57 (9/71)

☆U.S. GOVERNMENT PRINTING OFFICE - 1983-793-276

FILED May 9, 1984

BAKER COUNTY SURVEYOR

SURVEY NO. 10-35-175